


rev. datum	Datum	2016 06 21
RELATIONSHANDLING		
KV. SKATAN 7		
produktion SAVANAAB		
handläggare Zijo Golic arkitekt		
ansvarig Vesko Mijac		
TAKPLAN		
skala 1:200	nummer	A-200-001

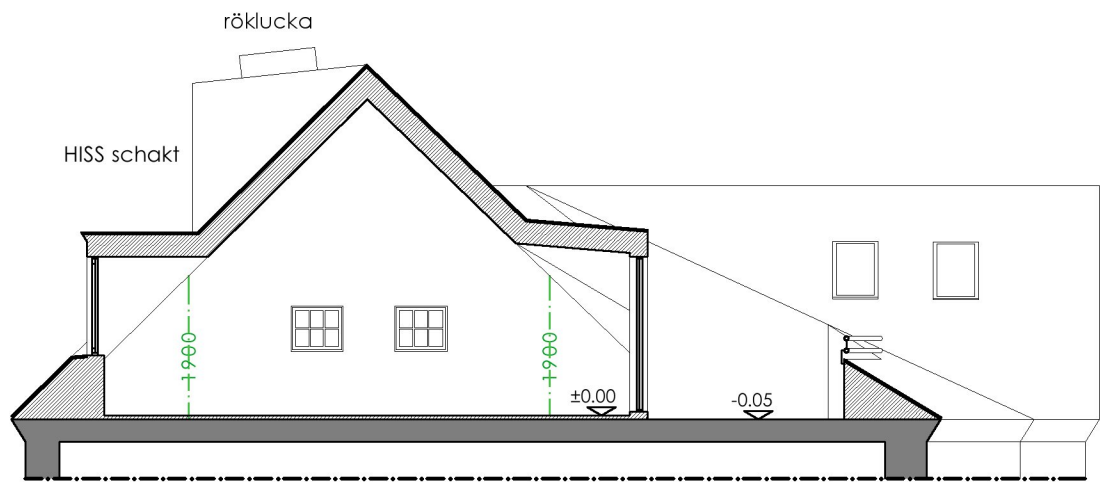

A-A

Rev. datum	Datum	2017 06 21
RELATIONSHANDLING		
KV. SKATAN 7		
produktion  SAVANAAB		
handläggare Zijo Golic arkitekt		
ansvarig Vesko Mijac		
SEKTION A-A		
skala 1:100	nummer	A-200-002