


Balkongrad A:
4000x1200

FASAD 1

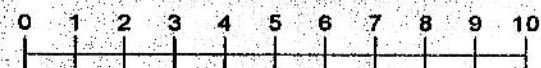

RELATIONSHANDLING Kv.Skatan 7
2019-04-01 /BB