
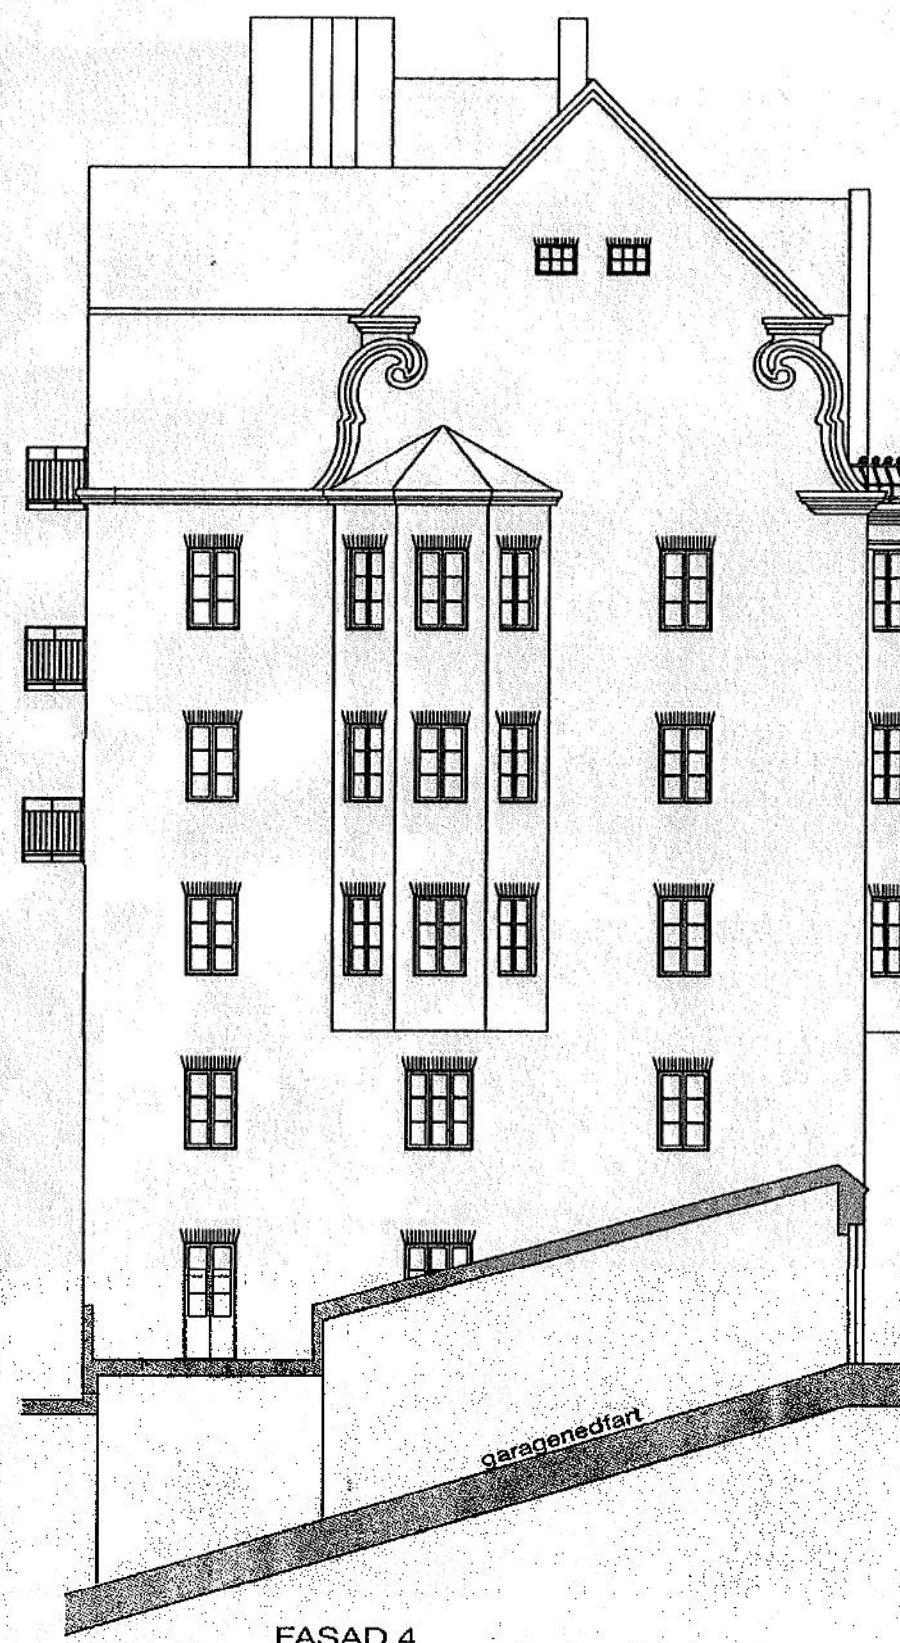


0 1 2 3 4 5 6 7 8 9 10

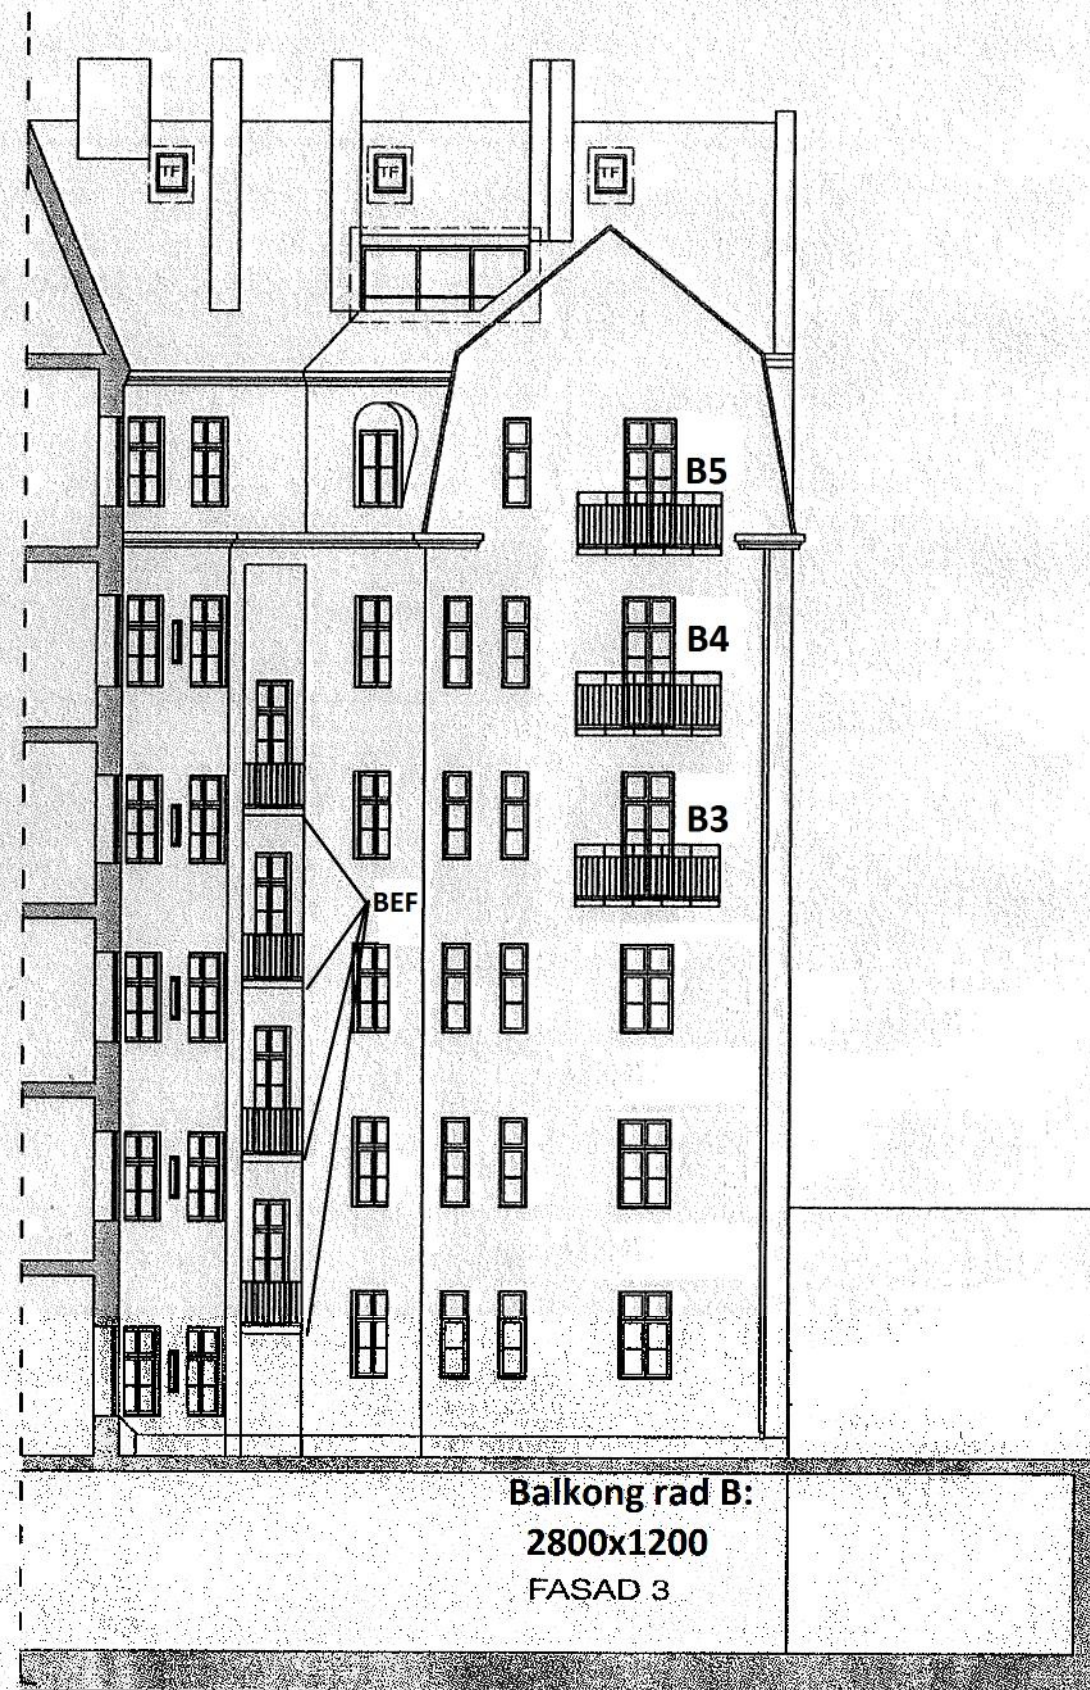

RELATIONSHANDLING
2019-04-02 / BB