

ENTRÉPLAN +16.5

RELATIONSHANDLING



Rev	Ant	Revidering avser	Sign	Datum
-----	-----	------------------	------	-------

Kv. Lehusen 11
Planritning, Lokal +16.5


Stockholm 2019-10-22
Stina Johansson - arkitekt SAR/MSA

Skala 1:100/A3

Ritn.nr. A-40.1-101

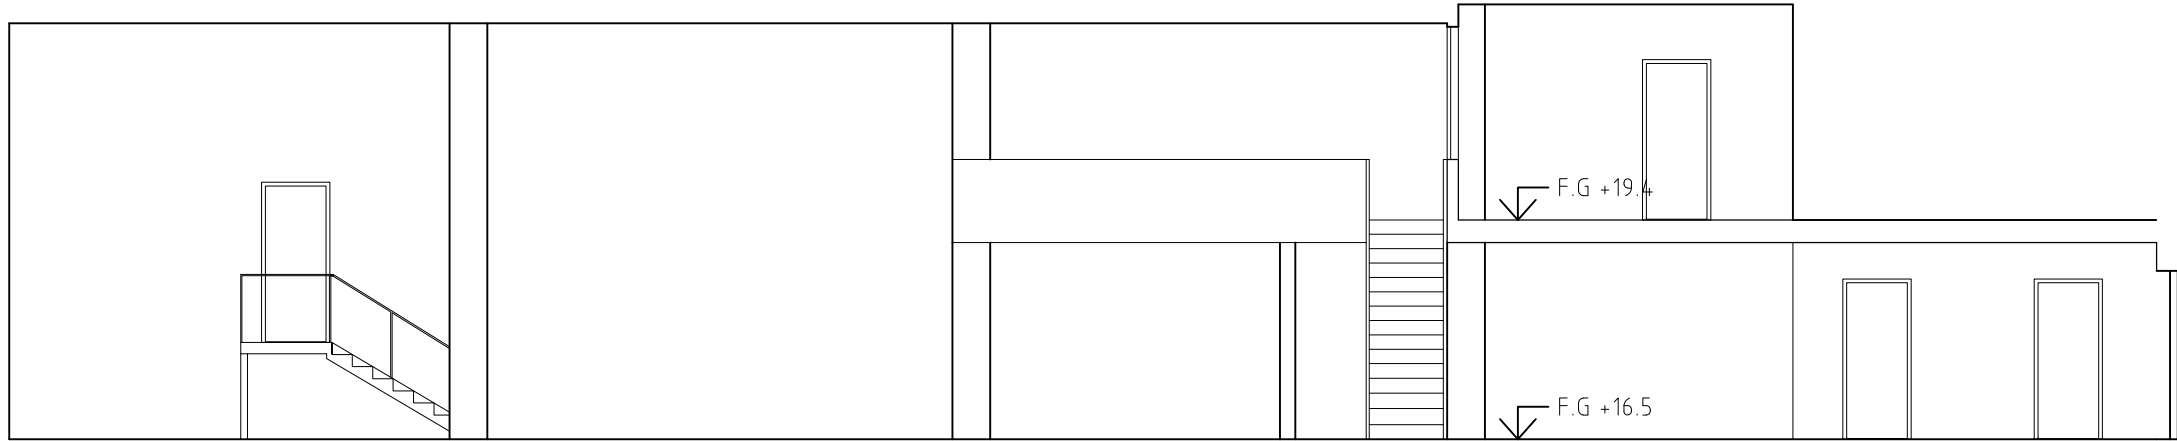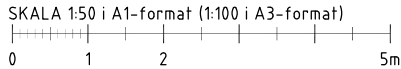

SEKTION A-A

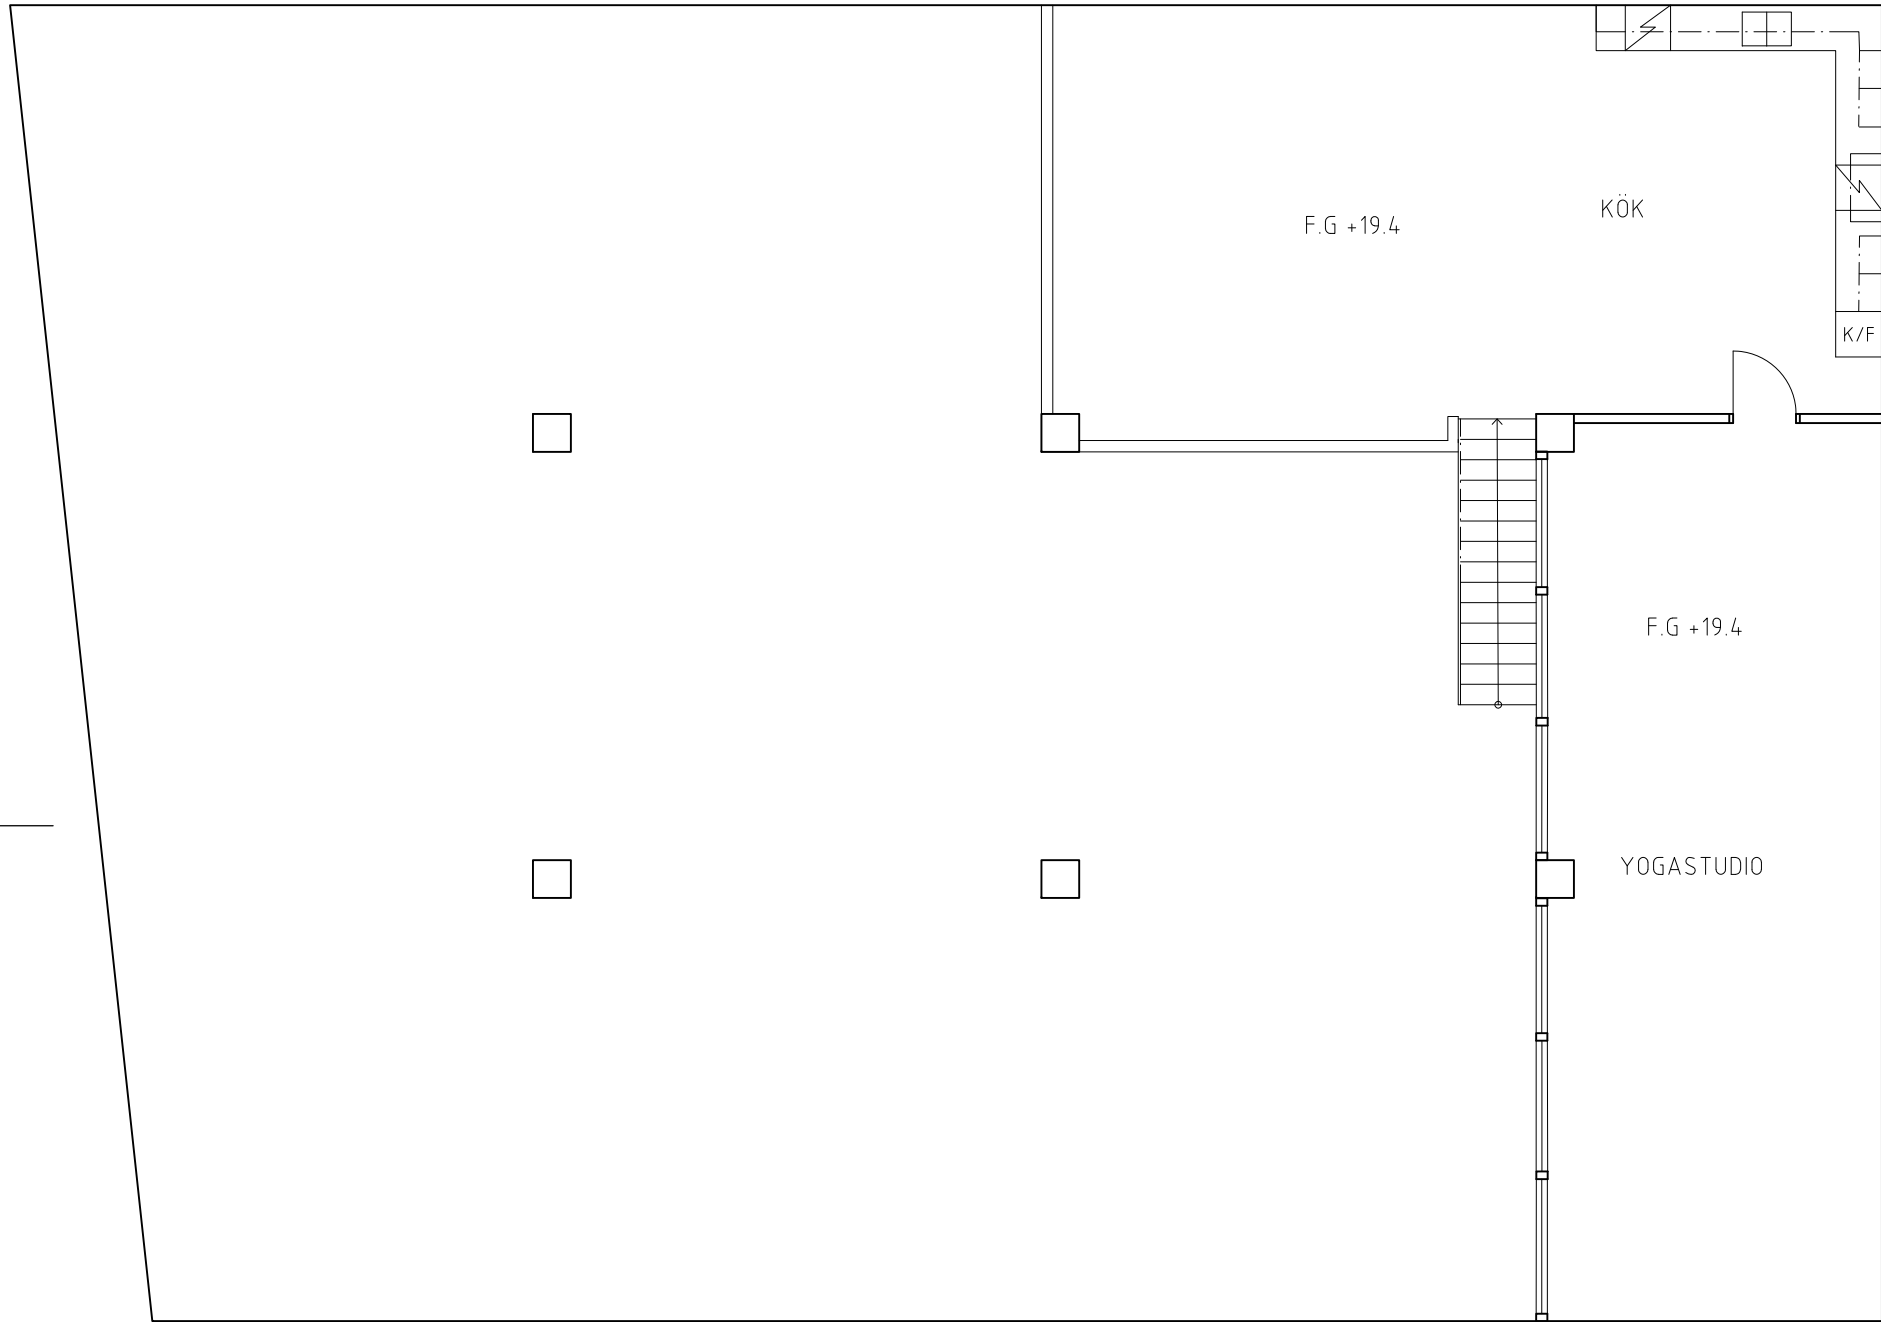

PLAN ENTRESOL +19.4

RELATIONSHANDLING

Stockholm 2019-10-22
Stina Johansson - arkitekt SAR/MSA

Rev	Ant	Revidering avser
-----	-----	------------------

Kv. Lehusen 11
Planritning, Lokal entresol +19.4
Sektion
Skala 1:100/A3
Ritn.nr. A-40.1-102