fixa med bord i stockroom +

ta bort back stitches

Doftbox på vån. 101

Takelevationer 101

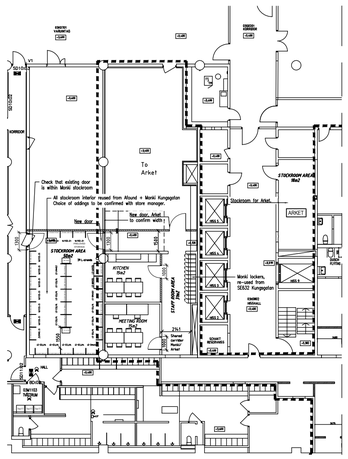

External BoH

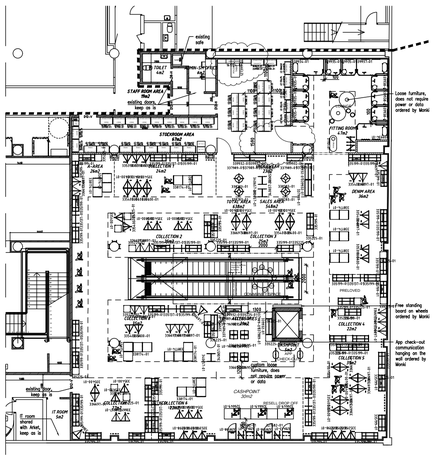

Main sales area

NOTES AND LEGEND

ALL DIMENSIONS GIVEN IN MM
ALL DIMENSIONS TO BE VERIFIED IN FIELD PRIOR TO CONSTRUCTION.
ALL DEVIATIONS MADE FROM THIS DRAWING SHOULD BE DISCUSSED WITH THE PROJECT RESPONSIBLE.

NOTE! CHECK PROJECT- OR INTERIOR CATALOGUE AS PRODUCT NUMBERS ON DRAWING MIGHT DIFFER ON ORDER.

POWER KEY:

- Furniture requiring power & IT. Cash desk. Power to be supplied from ceiling through powder coated aluminium cable tray, type Ecoline 60 x 60. Cash desk hardware to be installed on Spacepoles hardware, refer to SD-5859-0 for reference specification.
- Cash desk wardrobe, require no power
- Furniture requiring power. Fitting room cabin wall lights. Drivers for LED tube lights to be positioned behind cabinet. Power to be supplied through hidden bathroll walls in LED tubes mounted on both side of mirrors on walls. SC to confirm cost and feasibility of this with Monki. Refer to ovralex light adjustment on site. Refer to SD-5859-0.

FURNITURE KEY:

Code	Description
DS226-01	Tubeta, tower
DS187-01	Back stitch
DS187-01	Chain stitch
DS481-01	Threadpost
DS481-01	Threadpost bar
DS486-01	Threadpost double
	Bowls, ø 19
	Mirror break (re-used from Monki Kungsgatan)
	Window bench (re-used from Monki Kungsgatan)
	Fitting room lounge seating
	Fitting room cabins
DS-[illegible]	Drawp cabinet (double)
DS-[illegible]	Drapp drawer w. small mirror (deep)
DS-[illegible]	Drapp drawer w. flip-up mirror (small deep)
DS-[illegible]-01	Silky box (LHS)
DS-[illegible]-01	Silky liner (LHS)
DS-[illegible]-01	Patch work table
	Poster holder
	Cash desk unit
	Cash desk wardrobe
	Service desk

ALL MEASUREMENTS TO BE CHECKED ON SITE

0 — 10 m

B	Ex. door in fitting room	JH	2022-08-24
A	Tender drawings	JH	2022-03-25
REV	DESCRIPTION	SIGN	DATE

CLIENT: SE0639 Monki Drottninggatan new store 2022

MONKI

H & M Hennes & Mauritz GBC AB SE-105 47 Stockholm
Interior Department Tel: +46 8 7965500

STORE CODE: SE0639	DRAWING: PS300L
PROJECT: Monki	ARCHITECT: Bactor Gabular
DATE: 2022-03-25	DRAWN BY: Julia Medes
Layout: New Opening	Basement
DRAWING STATUS: 2022-09	PROJECT: MONKI DREAM MEASURE (SE0639)
SCALE: 1:100@A1	DRAWING NUMBER: 136-091 REV: B

This drawing is the property of HM Group. Copyright is reserved by law and the drawing is issued on the condition that it is not copied, reproduced, retailed or disclosed to any unauthorised person, either in whole or in part without the consent in writing of HM Group.

Inkom till Stockholms stadsbyggnadskontor - 2022-10-03, Dnr 2022-12608