

NOTES AND LEGEND

ALL DIMENSIONS GIVEN IN MM.
ALL DIMENSIONS TO BE VERIFIED IN FIELD PRIOR TO CONSTRUCTION.
ALL DEVIATIONS MADE FROM THIS DRAWING SHOULD BE DISCUSSED WITH THE PROJECT RESPONSIBLE.

NOTE! CHECK PROJECT- OR INTERIOR CATALOGUE AS PRODUCT NUMBERS ON DRAWING MIGHT DIFFER ON ORDER.

POWER KEY:

SCREEN
Installation requiring power & IT: Screens.
Number of screens and exact placement see elevation.
Local/Global BT team to support with suitable hardware installations (media player/box to play content).
No visible cables or sockets or other hardware than screen.


SOCKET
Socket to be able to support DJ booth

13amp socket to position indicated. Use brushed finish st. steel cover plates. Mount at 250mm AFFL.
All other visible sockets in store to have same finish. Refer to SD-645-0.


All existing power outlets to be kept, cover plates painted to match surrounding wall.

Existing sound system updated (if not already in place) to play separate music on ground floor and in basement.

NOTE:
All power according to H&M GBS.
The symbols above define additional Monki Power requirements.
Contractor to liaise with IT to ensure correct specification and quantities are installed.

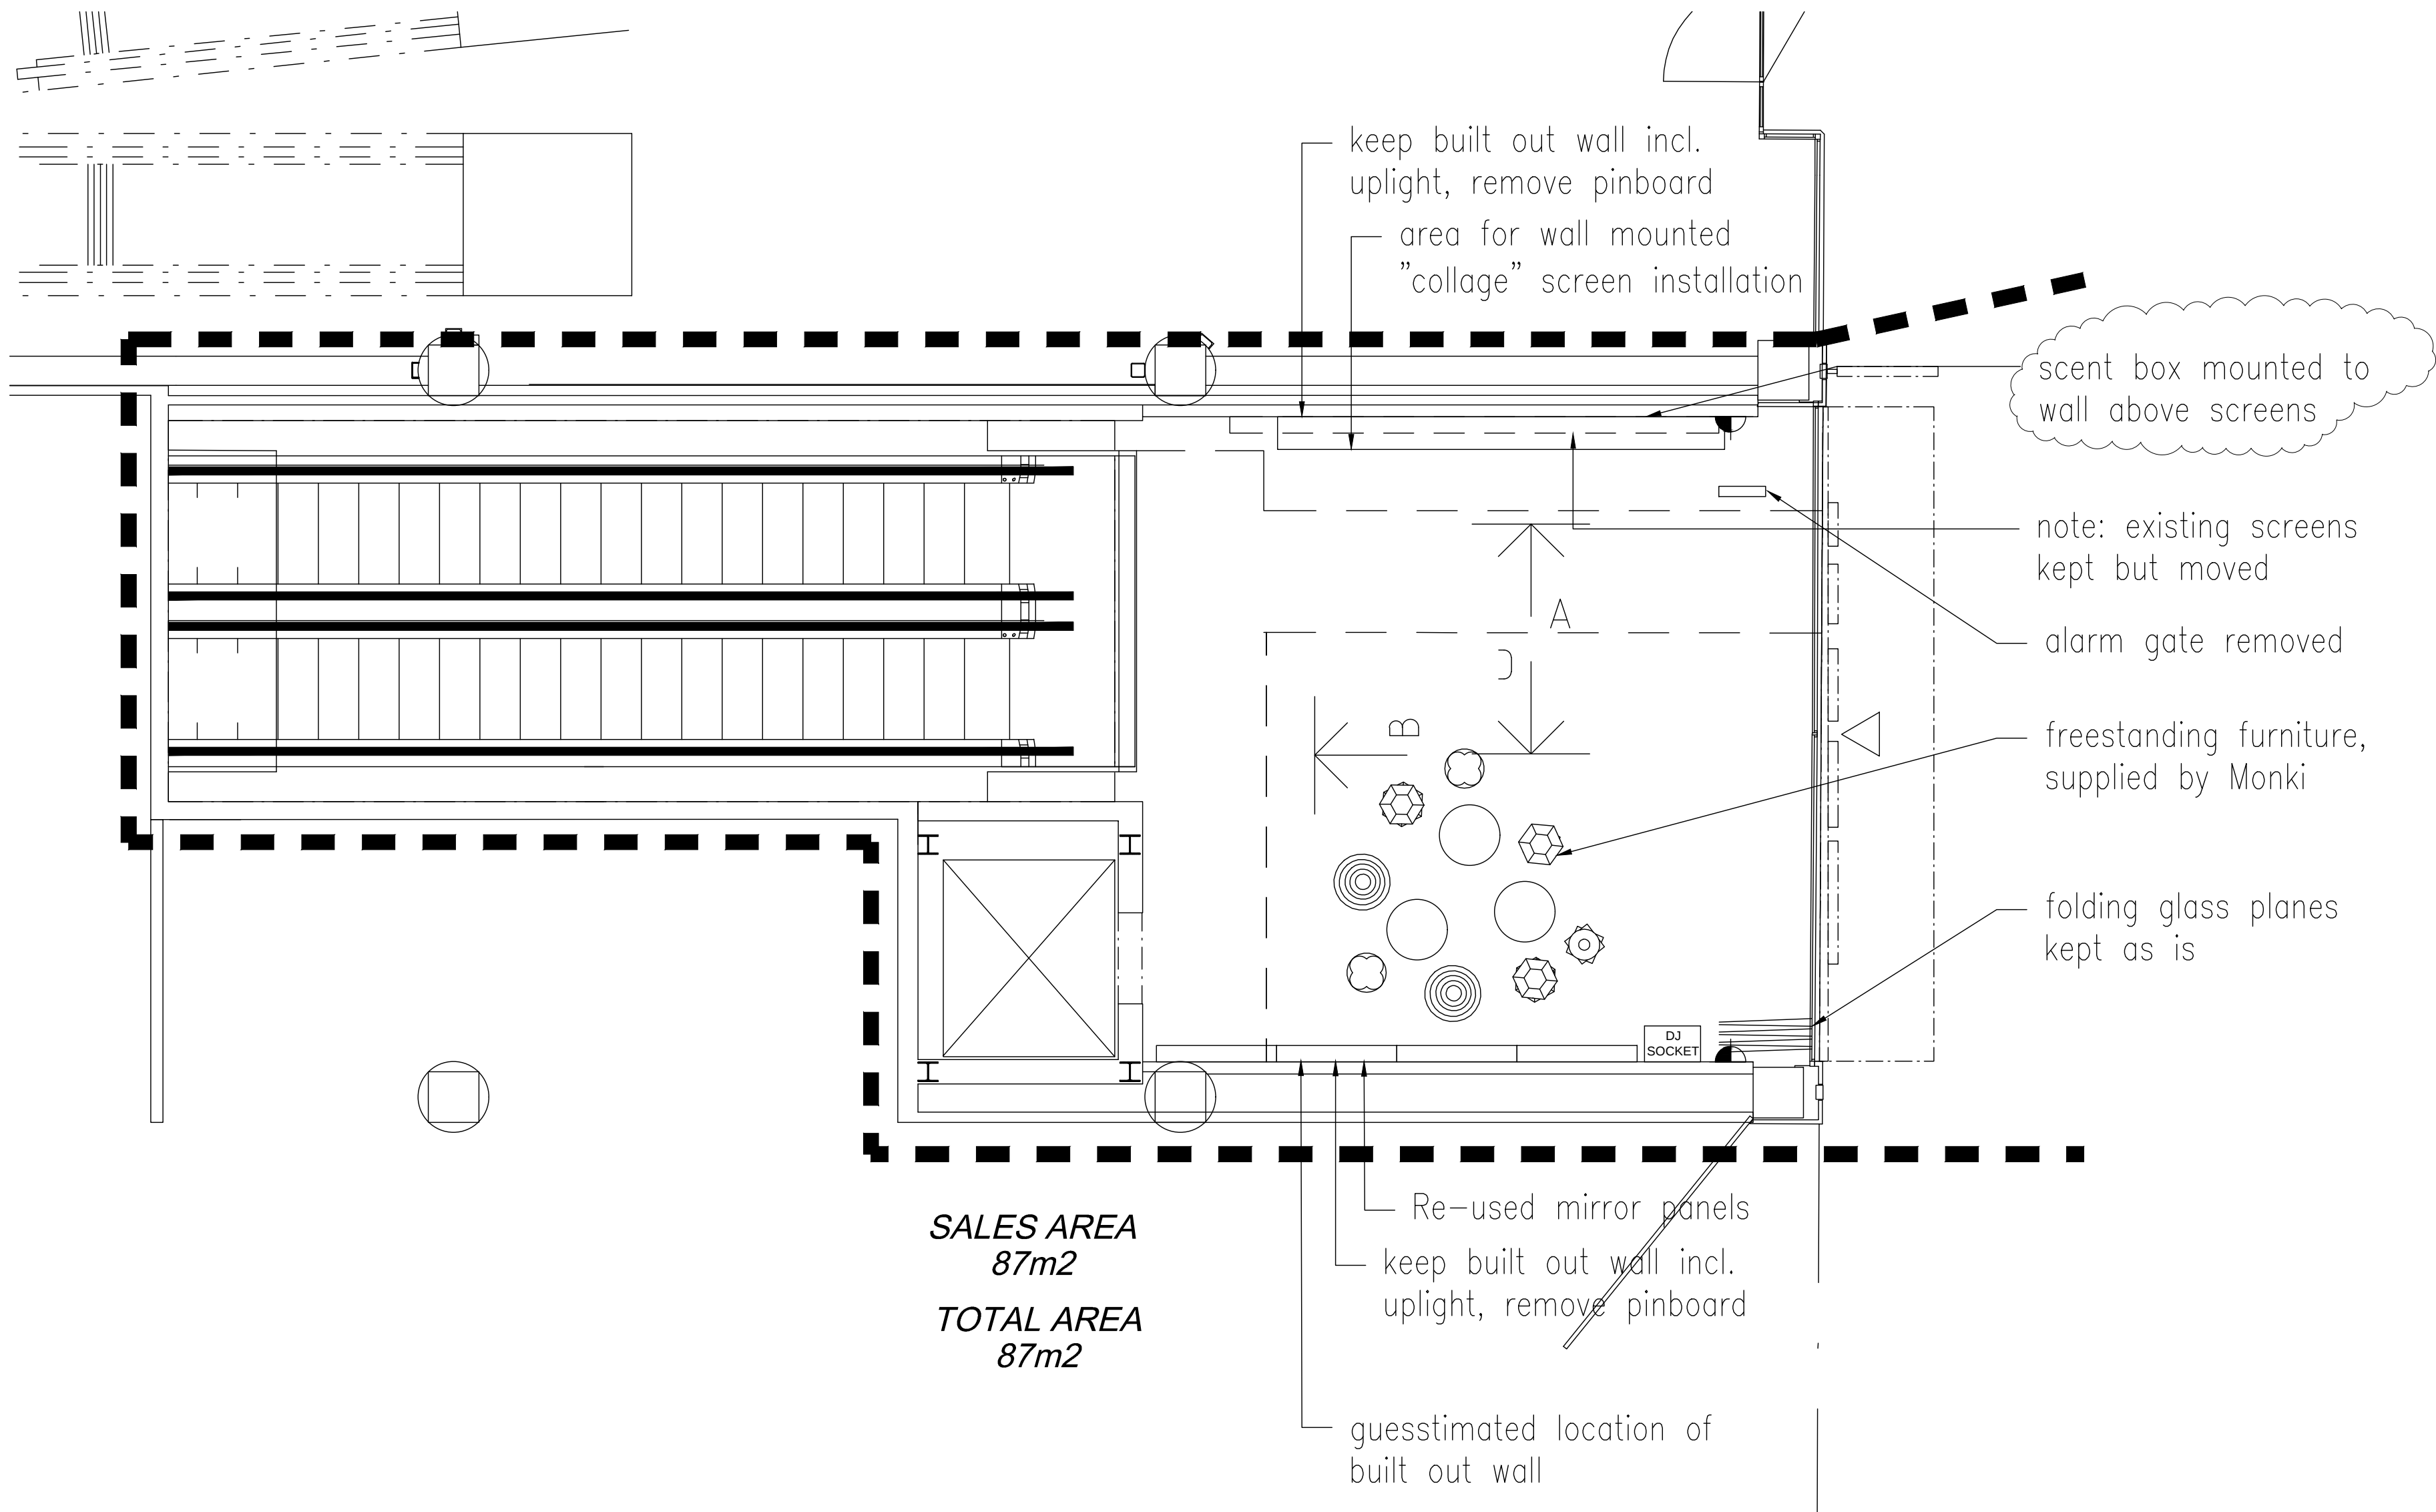

ALL MEASUREMENTS TO BE CHECKED ON SITE

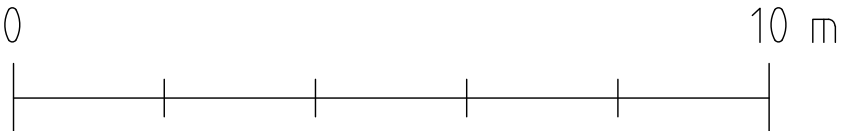

B	Scent box	JM	2022-08-29
A	Tender drawings	JM	2022-03-25
REV	DESCRIPTION	SIGN	DATE
CLASS			
SE0639 Monki Drottninggatan, new store 2022			
MONKI			
H & M Hennes & Mauritz GBC AB SE-105 47 Stockholm Interior Department Tel: +46 8 7965500			
STORE CODE	ENTITY ID		
SE0639	P57004		
CLASS	PROJECT MANAGER		
Monki	Bachir Gaouar		
DATE	STORE PLANNER		
2022-03-25	Julia Madas		
Layout	Ground Floor		
NewOpening	New Location		
OPENING SEASON	PRODUCT LIST		
2022-09	Monki - MONKI DREAM WEAVEY (423827)		
SCALE	DRAWING NAME	REV	
1:50@A1	I36:101	B	
This drawing is the property of HM Group. Copyright is reserved by them and the drawing is issued on the condition that it is not copied, reproduced, retained or disclosed to any unauthorised person, either or wholly or in part without the consent in writing of HM Group.			