


PLAN VÄN TR.1

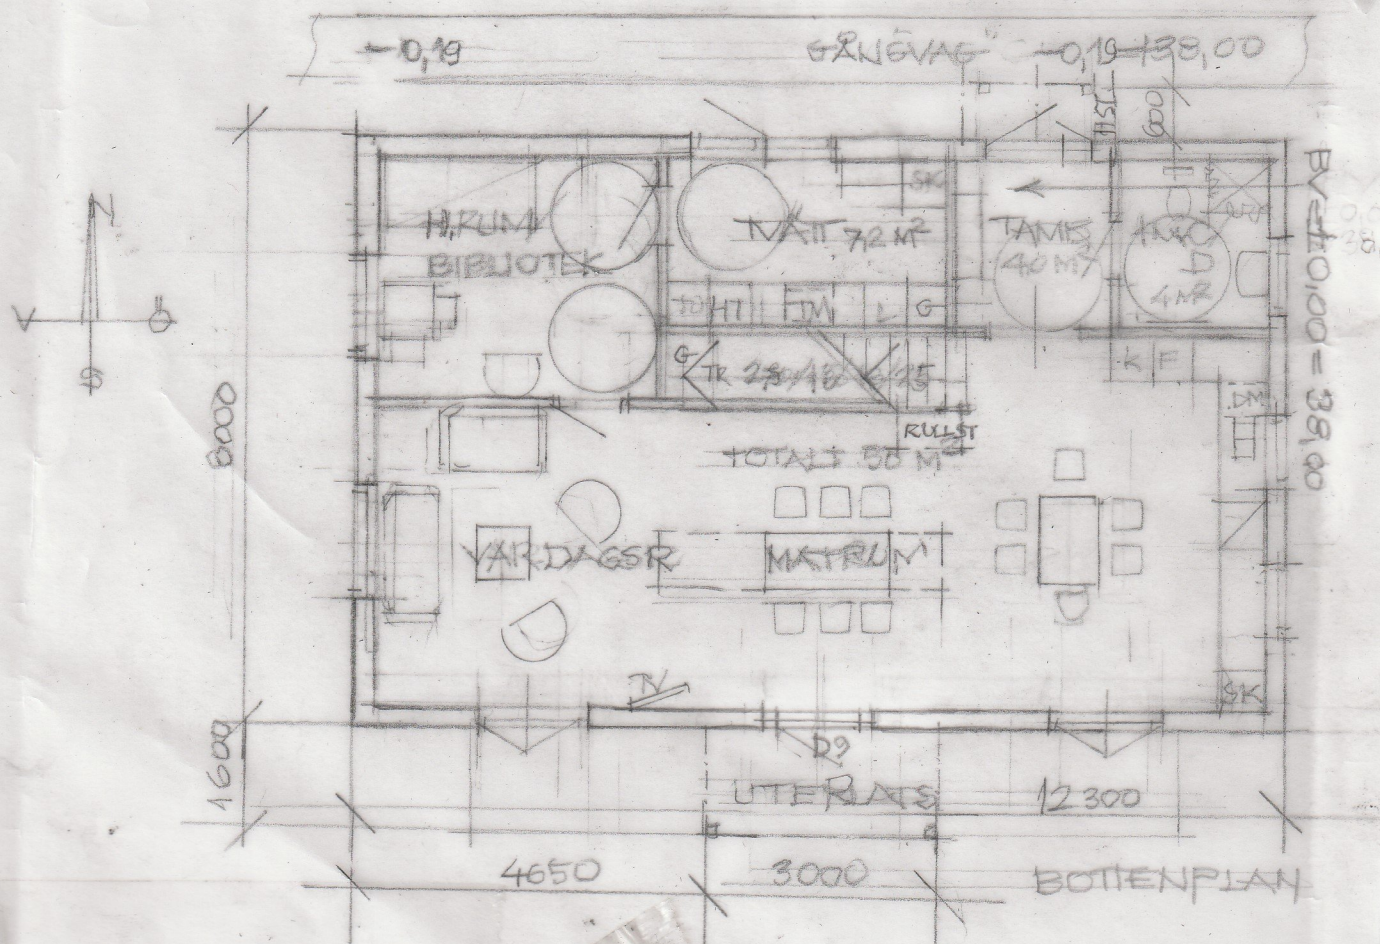

BOTTENPLAN

BYRÅCHEFEN 5 STOCKHOLM

Planer i skala 1:100 Lidingö 2022 11 08

Schömer Consultant KB Ervin Schömer arkitekt SAR

2

REV 2022-12-21

BALKONG BORT.