




Stadsbyggnadskontoret

Inkom 2023 -02- 24  
Reg.

Dnr:

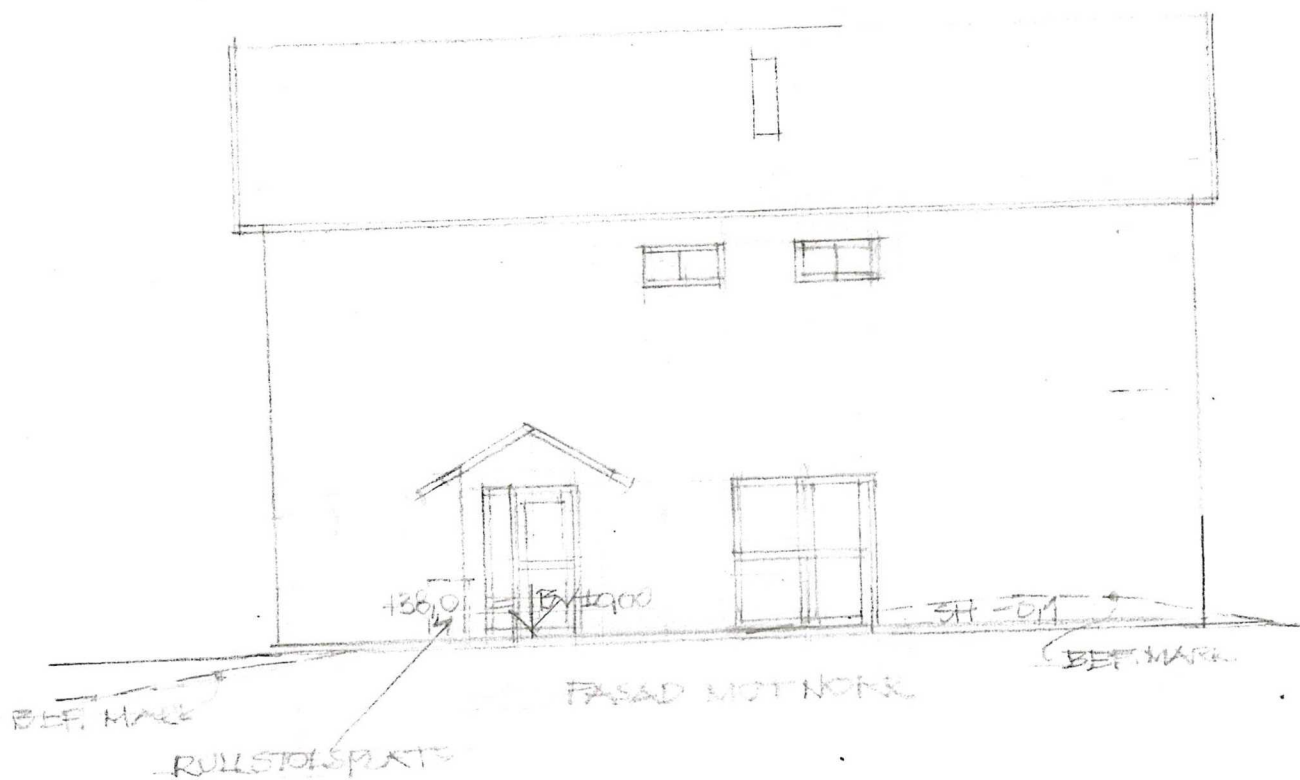

0 1 2 3 4 5 6 7 8 9 10M

SKALA = 1:100

SÄMTLIGA FASADER AV VERTIKAL  
LOCKPANEL 22x150

5

REV 2022-12-21 ALLM.  
2023-02-20