




BEF. SEKTION A-A
1 : 100

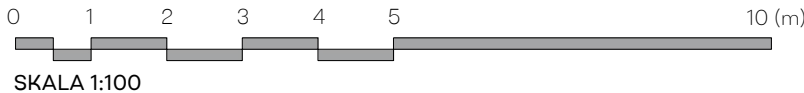

Drängen 5		
RITNING	RITNINGSNUMMER	
SEKTIONS-RITNING	A-05.33-102	
RITAD/KONST.AV	DATUM	SKALA
S.S.	2023/06/02	1 : 100

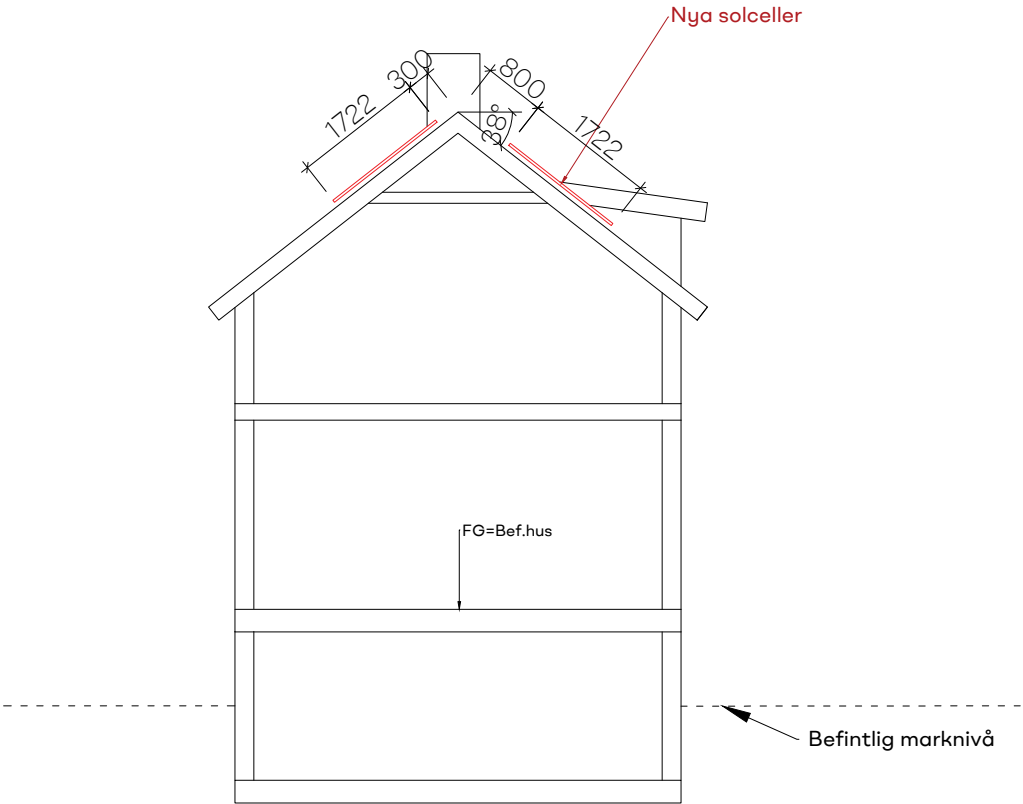

NY SEKTION A-A
1:100

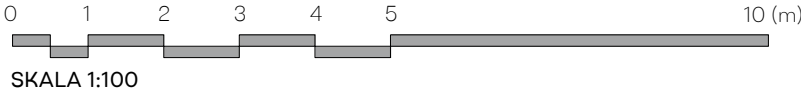

Drängen 5		
RITNING	RITNINGSNUMMER	
SEKTIONS-RITNING	A-05.33-105	
RITAD/KONST.AV	DATUM	SKALA
S.S.	2023/06/02	1:100