
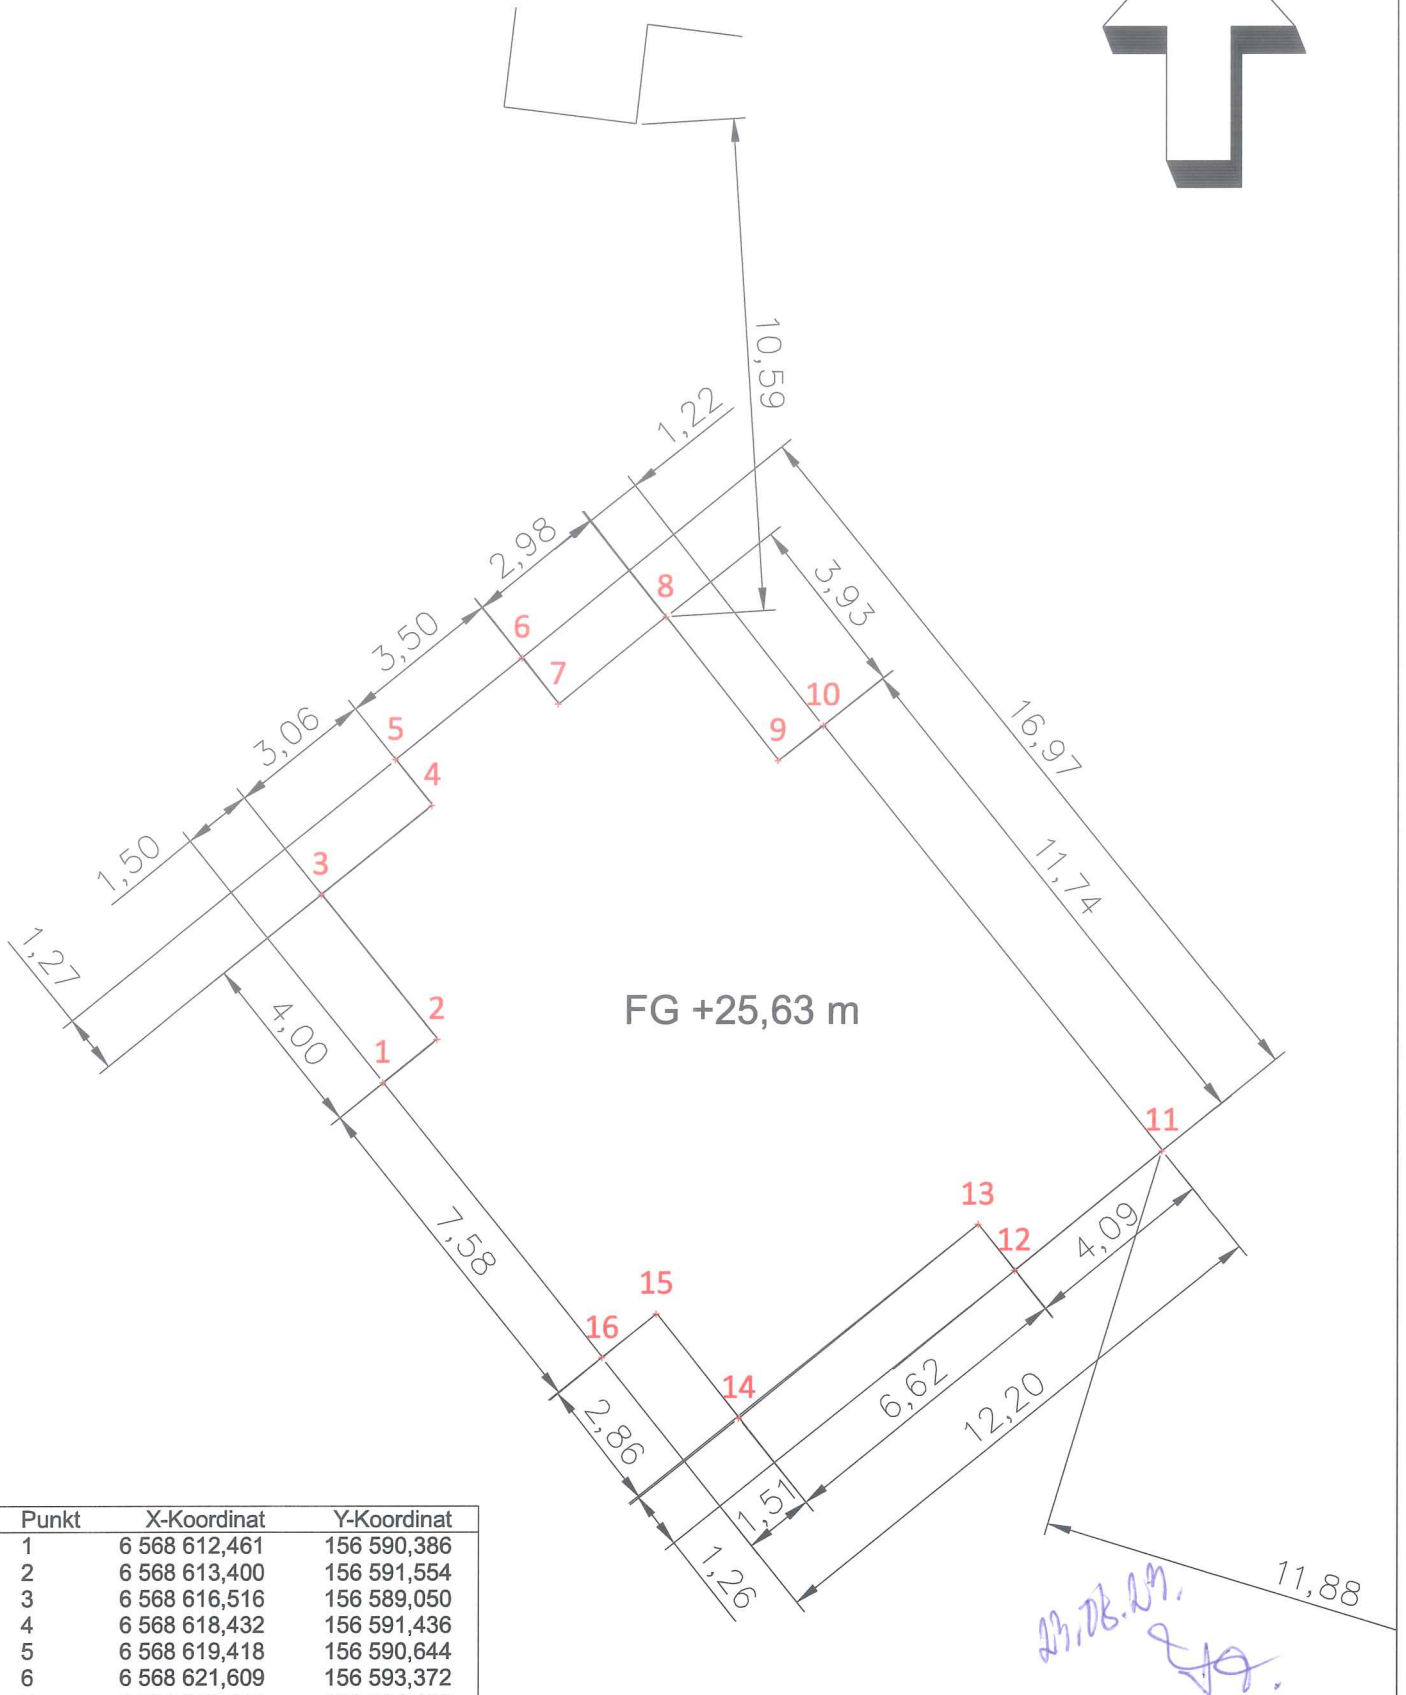


Bef. byggnad

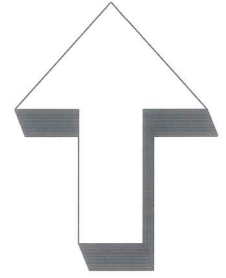

Punkt	X-Koordinat	Y-Koordinat
1	6 568 612,461	156 590,386
2	6 568 613,400	156 591,554
3	6 568 616,516	156 589,050
4	6 568 618,432	156 591,436
5	6 568 619,418	156 590,644
6	6 568 621,609	156 593,372
7	6 568 620,615	156 594,155
8	6 568 622,486	156 596,479
9	6 568 619,395	156 598,913
10	6 568 620,151	156 599,873
11	6 568 610,984	156 607,205
12	6 568 608,414	156 604,026
13	6 568 609,401	156 603,242
14	6 568 605,251	156 598,084
15	6 568 607,489	156 596,306
16	6 568 606,548	156 595,128

GG  
TEKNIK  
GG Teknik och Service AB  
Svärdvägen 21  
SE-18233 Danderyd  
Tel: 072-961 48 85  
E-post: goran@ggtek.se, Hemsida: www.ggtek.se

RITAD AV, KONSTRUERAD AV  
Daniel Stawe

ARB.NR.  
1

2023-08-08

Lägeskontroll - byggnad (fasad)

Farsta Strand 2:1

Dnr. 2018-14514 - 575

Forsen 12, 123 72 Farsta

SWEREF 99 18 00 RH 2000

SKALA  
1:115

HÄJDSKALA

RITNINGNUMMER

1

REV