




Befintlig galsparti

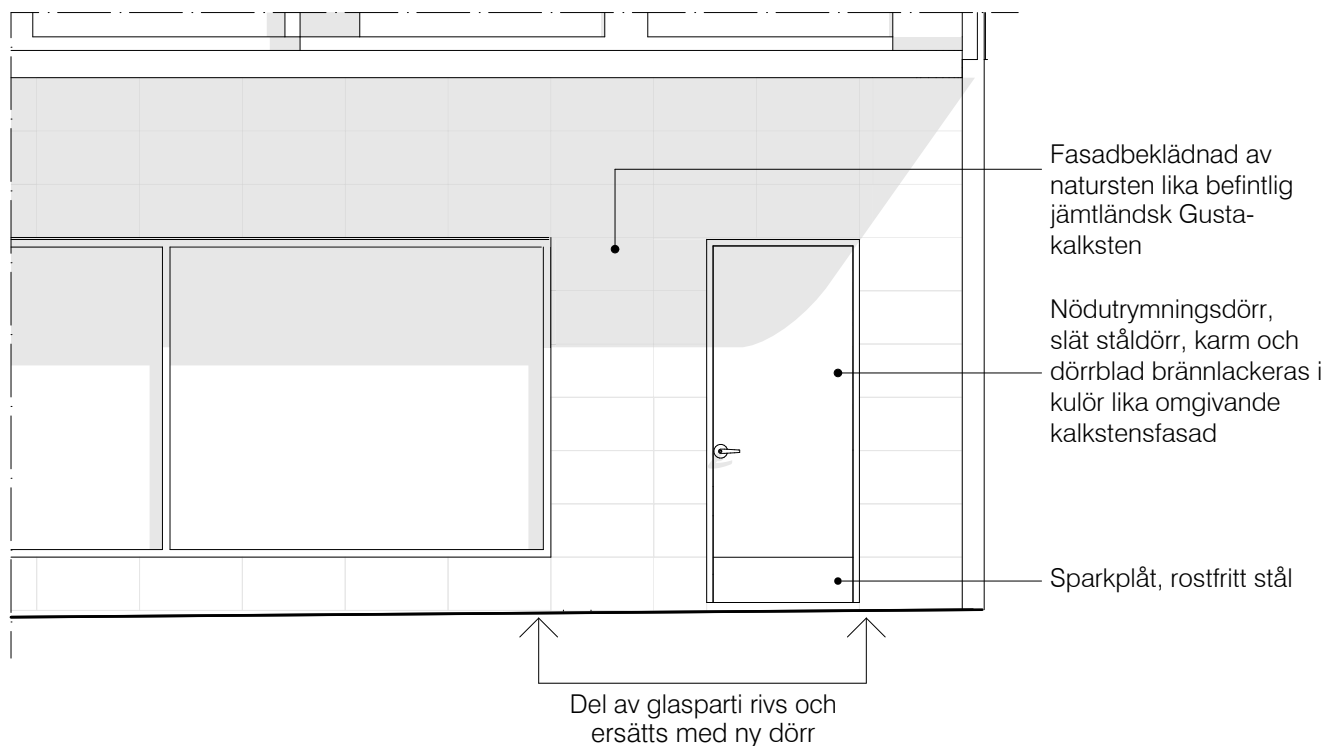

**Larsson  
Ark.**

SKALA 1:50

