


FASAD MOT SÖDER, DEL 1

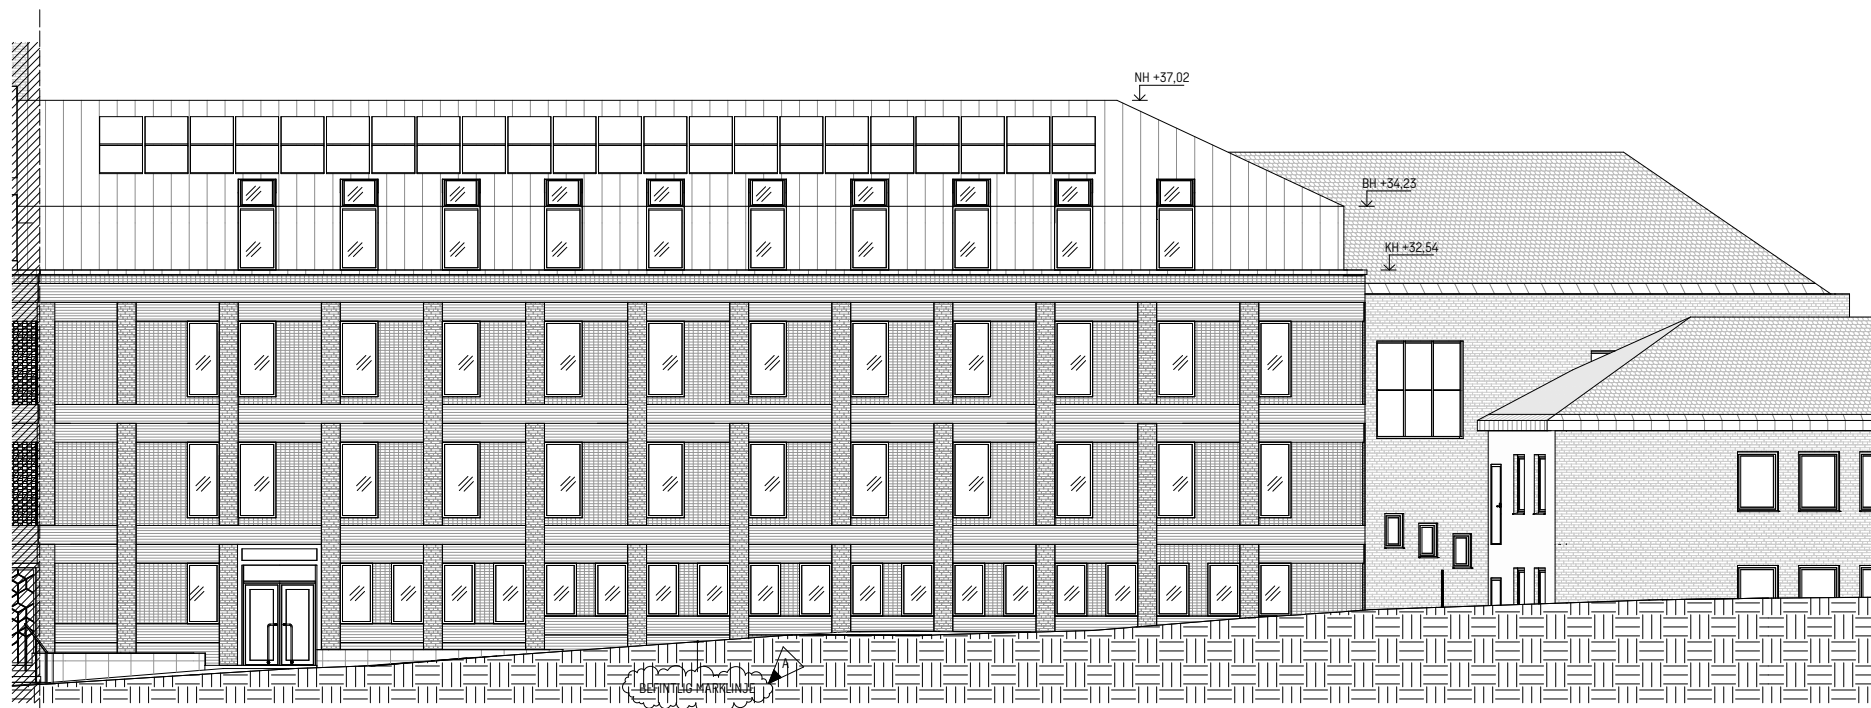

FASAD MOT SÖDER, DEL 2

FG +31,69
PLAN 7

FG +28,49
PLAN 6


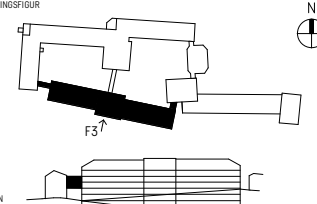
FG +25,29
PLAN 5

FG +22,09
PLAN 4

SKALA 1:100

0 1 2 5 10

METER

A	A-PM01	2024-01-10	SEAAMK
BET	ANT	ÄNDRINGEN AVSER	SIGN
BYGGLOVHANDLING			
LYSBOMBEN 5 RÅLAMBSVÄGEN 3, 112 59 STOCKHOLM			
KUND			
			
ORIENTERINGSDIAGRAM			
			
PLAN			
SEKTION			
A SWECO ARCHITECTS 08 695 60 00			
LA SWECO ARCHITECTS 08 695 60 00			
K LOOSTRÖM 08 755 11 60			
E - -			
V HLG PROJEKT AB 073 944 40 08			
W - -			
Br C/O BRAND RISK 08 522 050 21			
M - -			
UPPDRAG NR 30034912		RITAD/KONSTR AV SEBVIN	HANDLAGGARE SEBVIN
DATUM 2023-09-29		ANSVARIG SEAAMK	
NYBYGGNAD FASAD MOT SÖDER			
SKALA A1 = 1:100 A3 = 1:200	NUMMER A-40-3-003	BET A	