
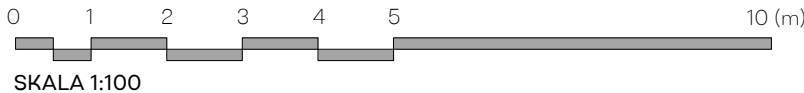


(14 solceller 1722±2 X 1134±2 X 30±1)

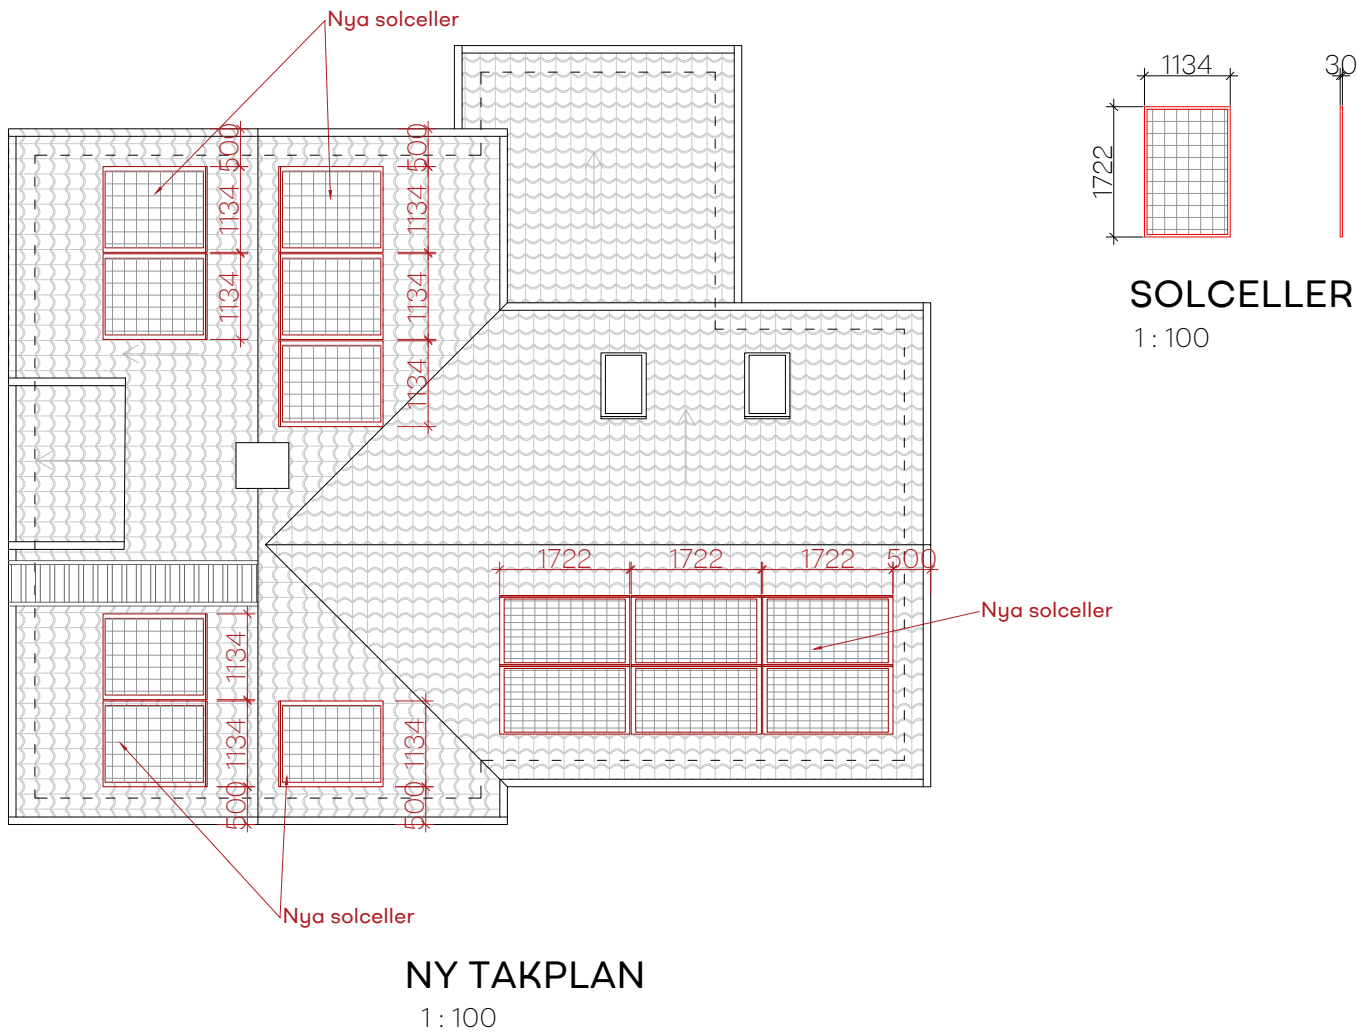

Drängen 5			
RITNING		RITNINGSNUMMER	
PLANRITNING		A-05.33-104	
RITAD/KONST.AV	DATUM	SKALA	
S.S.	2023/06/02	1:100	