


FASAD MOT SÖDER, DEL 1

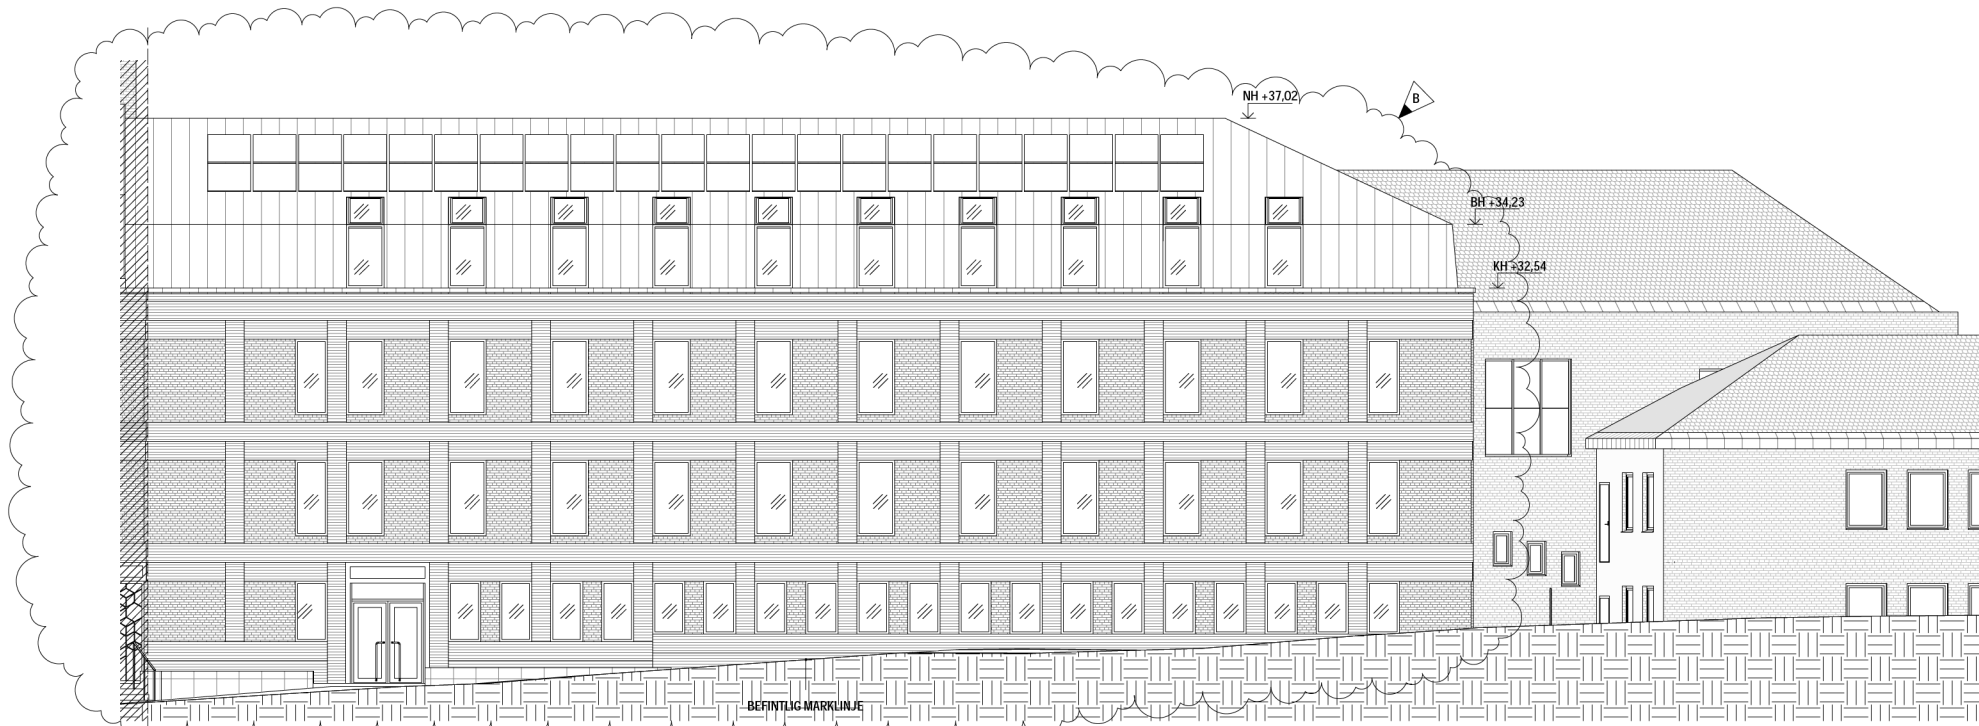

FASAD MOT SÖDER, DEL 2

FG +31,69  
PLAN 7

FG +28,49  
PLAN 6

FG +25,29  
PLAN 5

FG +22,09  
PLAN 4

SKALA 1:100

0 1 2 5 10

METER

B	A-PM03	2024-03-08	SEAAMK
A	A-PM01	2024-01-10	SEAAMK
BET	ANT	ÄNDRINGEN AVSEER	ISGN


## BYGGLOVHANDLING

LYSBOMBEN 5  
RALAMBSVÄGEN 3, 112 59 STOCKHOLM

KUND



ORIENTERINGSFIGUR

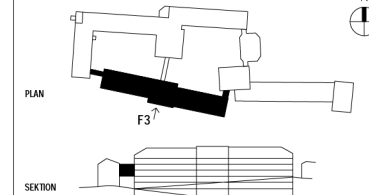

A	SWECO ARCHITECTS	08 695 60 00
LA	SWECO ARCHITECTS	08 695 60 00
K	LOOSTRÖM	08 755 11 60
E	-	-
V	HLG PROJEKT AB	073 944 40 08
W	-	-
Br	C/O BRAND RISK	08 522 050 21
M	-	-

UPPDRAGS NR	RITAD/KONSTR AV	HÄNDLAGGARE
30034912	SEBVIN	SEBVIN
DATUM	ANSVARIG	
2023-09-29	SEAAMK	

NYBYGGNAD  
FASAD MOT SÖDER

SKALA	NUMMER	BET
A1 = 1:100 A3 = 1:200	A-40-3-003	B