



Date: 05.02.2024

Company Name: -

Order Name: -

Order Code: 24-0364

Construction Color: -

Pergola Fabric Color: -

Pergola Fabric Profile Color: -

Sky Palette Color: -

Zip Construction Color: -

Zip Fabric Color: -

LED Type: -

Drawn By: Selvihan Çalı

Revizyon No: R_00

Revizyon Tarihi: 00.00.2023

Revizyon No: R_00

Revizyon Tarihi: 00.00.2023

Çizilen ve onaylanan projeler sözleşme niteliğindedir. Onaylı bu projeye göre üretilmiş tüm ürünler her iki taraf için de doğru kabul edilir.





Projects drawn and approved are in the nature of a contract. All products produced according to this approved project are considered correct for both parties.

SUNSET PERGOLA DIŞ TİCARET A.Ş.

Küçükbakkalköy Mah. Dudullu Cad.
Brandium R2 Rezidans Blok No:23-25B/265

ATASEHIR / ISTANBUL / TURKEY

sales@sunsetpergola.com.tr

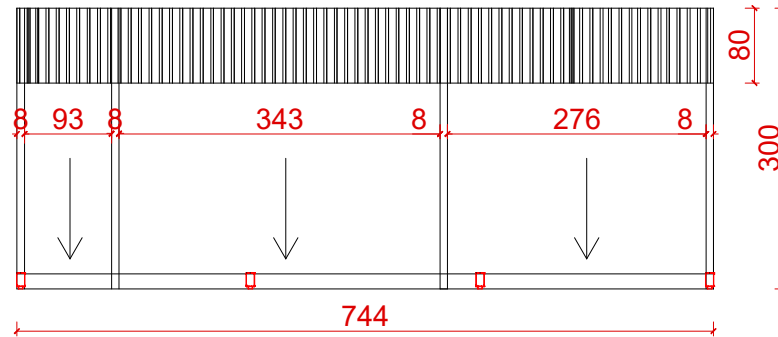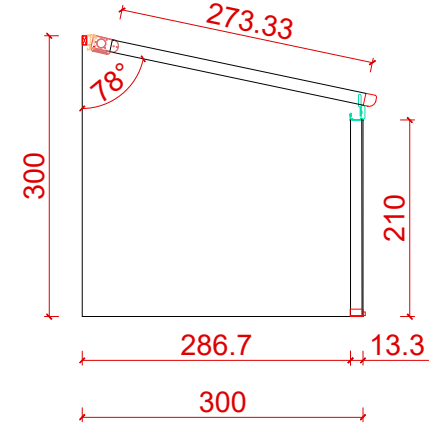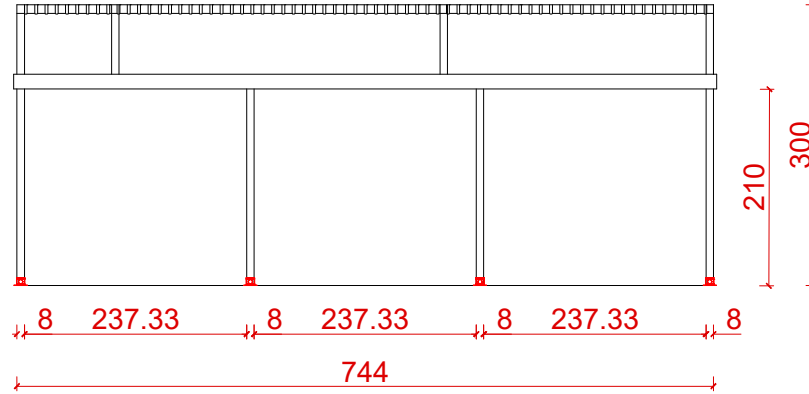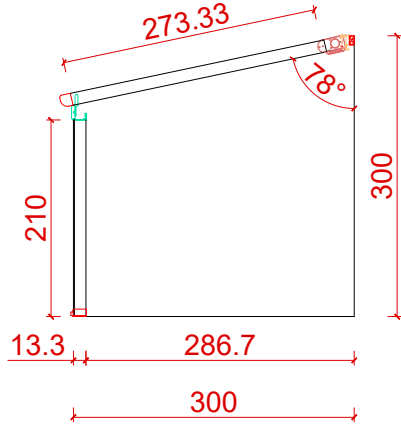

21-3467 kodlu projede askı aparatları iptal edilip dikmeler eklenecektir.Yalnızca dikmeler verilecektir.

The hanging apparatus parts will be cancelled.
4 pcs pillar will be given for the new project.