



3A1 HUS J1


ENLTYPE 304
Z RIFA 1751

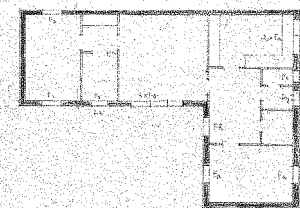

3A2 HUS-12

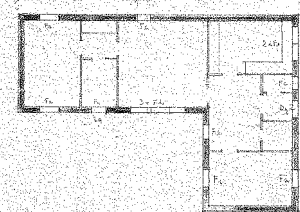


3 A3 HUS A2

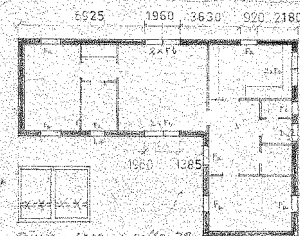

3A4 HUS D9


I VARDAGSRUM 50 SKALL 2 ST FÖN-
STERPARTIER 2X65 ANDRAS GENOM
ATT HORIZONTALA FÖNSTERFÖSTER
BORTTAGES OCH ATT STÖRRE OCH
TILLRE FÖNSTERFÖRÄGAR SAMMANSLA
S I EN BÅGE I VARDERA FÖNSTER-
HETEN

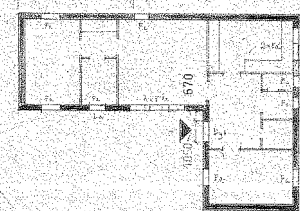

3 A5 HJS D5

1) ELUTING: FÖR ELEKTRISKT VÄGGUR
UPPSÄTTES FÖR VÄGG MEN ÖVER
DÖRR I KÖKT RUM 40 I HUS 17


2) I VILLA D5 I BADRUM 30 SKALL TVÄTT
STÄLL GUSTAVSBERG 525 UTGÅ I STA
LET UPPSÄTTES TVÄTTSTÄLL MED SEP.
TANDEBORSTÅL 700x420.

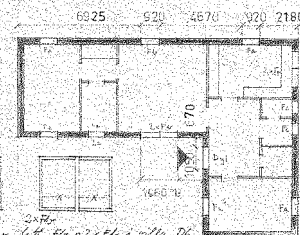

3 A6 HUS D-6

1) I VARDAGSRUM 50 I HUS D6 SKALL FÖNSTER LITTE ÖR 2F6 ANDRAS GEMOM ATT HORIZONTELLA FÖNSTER POSTER BORTAGAS OCH ATT STÖRRE OCH MINDRE FÖNSTER BÅGE SAMMANSLÅS TILL EN BÅGE I VARDAGSRUM FÖNSTERENHET.

2) I KÖK 40 I HUS D6 SKALL KÖKSVENTILATOR TYP FUTURUM I KOMBINATION MED EXTRA ÖVESKÅR INSTALLERAS.

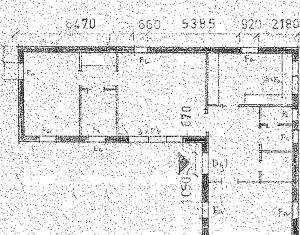

3A7 ENC 88


$$L_y = 95.4 \text{ m}^2$$
[illegible]