


N 6579094
E 674199

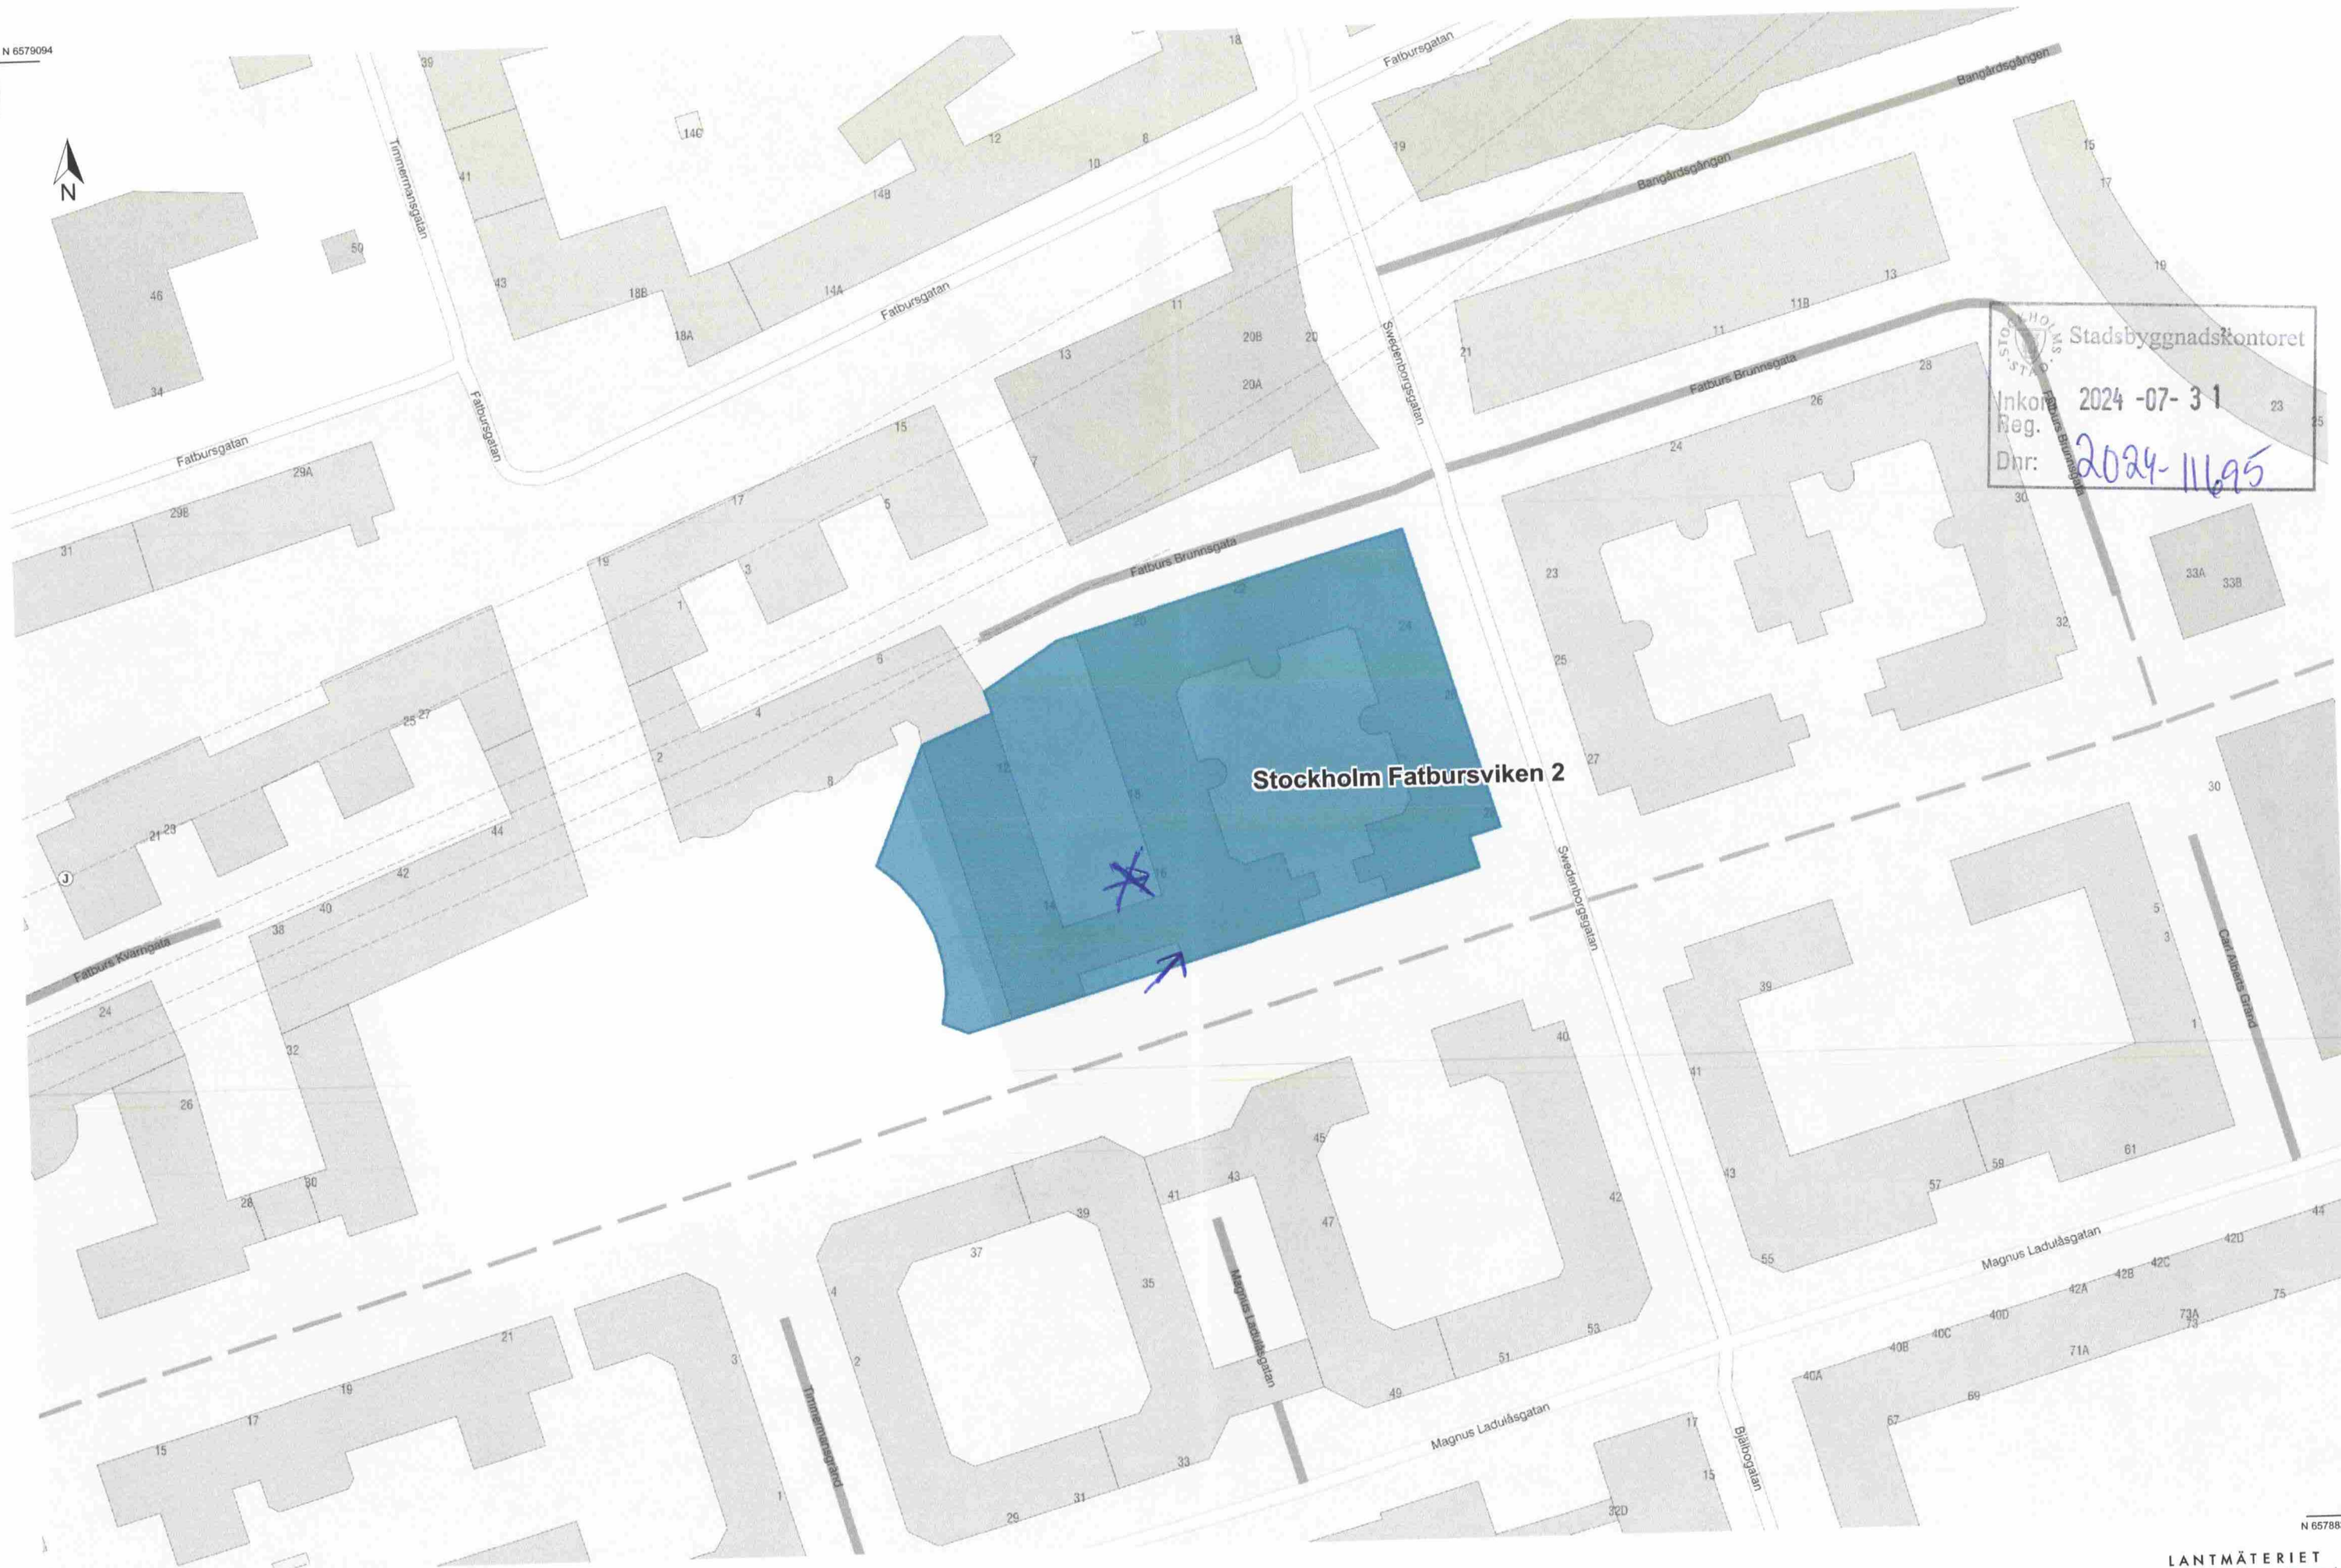

STOCKHOLM
STAD
Stadsbyggnadskontoret
Inkom 2024 -07- 31
Reg.
Dnr: 2024-11695

0 40 80 120 m
Skala 1:1 000. SWEREF 99 TM. RH 2000.

LANTMÄTERIET

N 6578831
E 674598