


V403. PLAN 19, TERRASSBALKSDETALJ

1 : 10

I

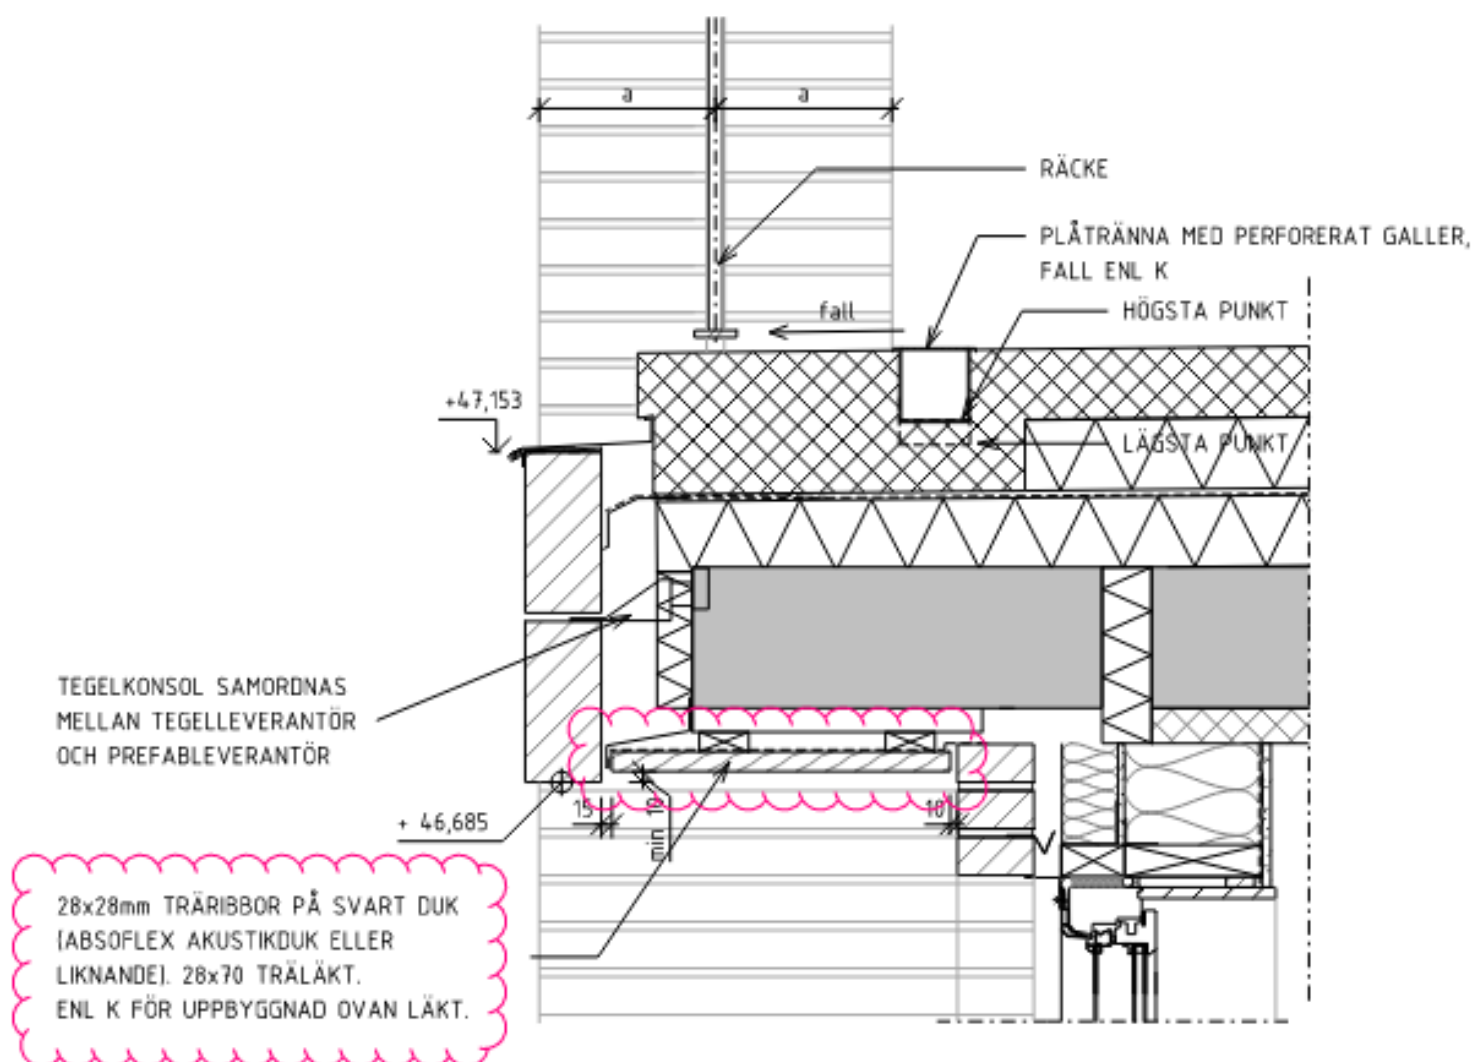

V404. PLAN 19, TERRASSKANTSDETALJ

1 : 10