



Date: 05.02.2024

Company Name: -

Order Name: -

Order Code: 24-0364

Construction Color: -

Pergola Fabric Color: -

Pergola Fabric Profile Color: -

Shade Palette Color: -

Construction Color: -

Pergola Fabric Color: -

Shade Type: -

Drawn By: Selvihan Çalı

Revizyon No: R_00

Revizyon Tarihi: 00.00.2023

Revizyon No: R_00

Revizyon Tarihi: 00.00.2023





Çizilen ve onaylanan projeler sözleşme kapsamındadır. Onaylı bu projeye göre üretilmiş ürünler her iki taraf için de doğru kabul edilir.

Projects drawn and approved are in the nature of a contract. All products produced according to this approved project are considered correct for both parties.

SUNSET PERGOLA DIŞ TİCARET A.Ş.

Küçükbakkalköy Mah. Dudullu Cad.
Brandium R2 Rezidans Blok No:23-25B/265

ATASEHIR / ISTANBUL / TURKEY
sales@sunsetpergola.com.tr

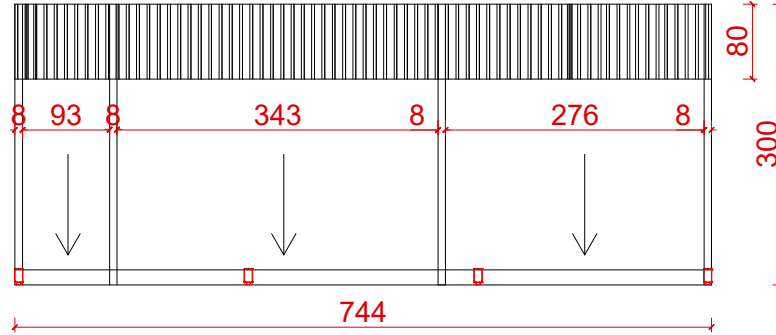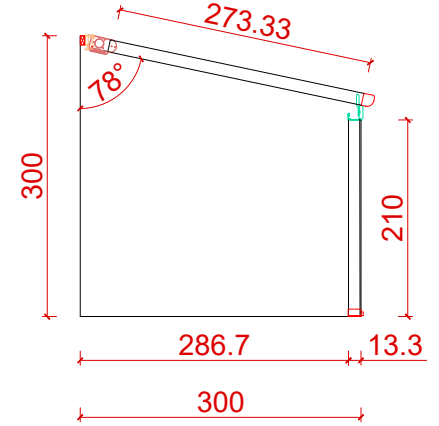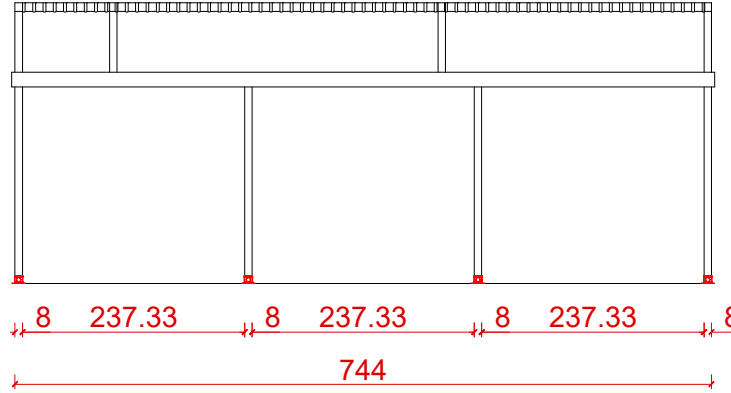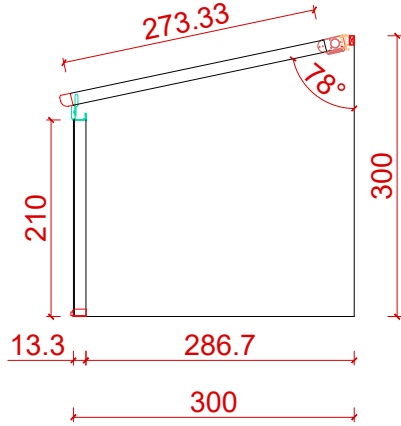

21-3467 kodlu projede askı aparatları iptal edilip dikmeler eklenecektir.Yalnızca dikmeler verilecektir.

The hanging apparatus parts will be cancelled.
4 pcs pillar will be given for the new project.