
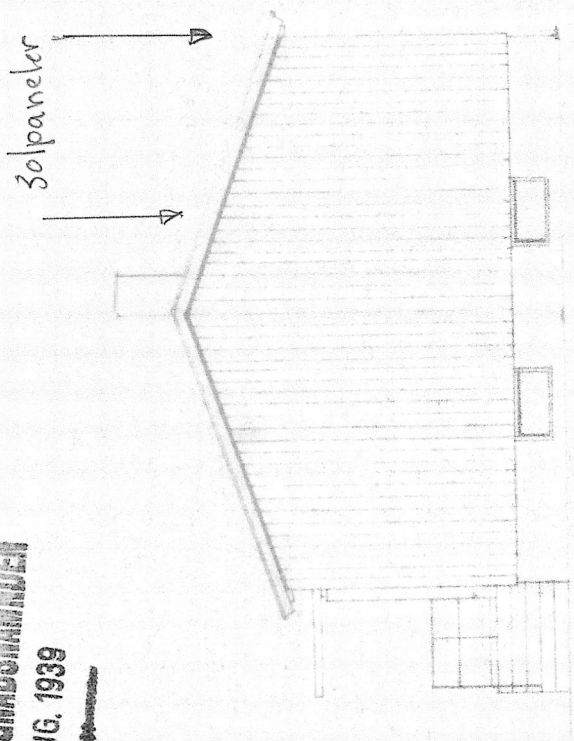
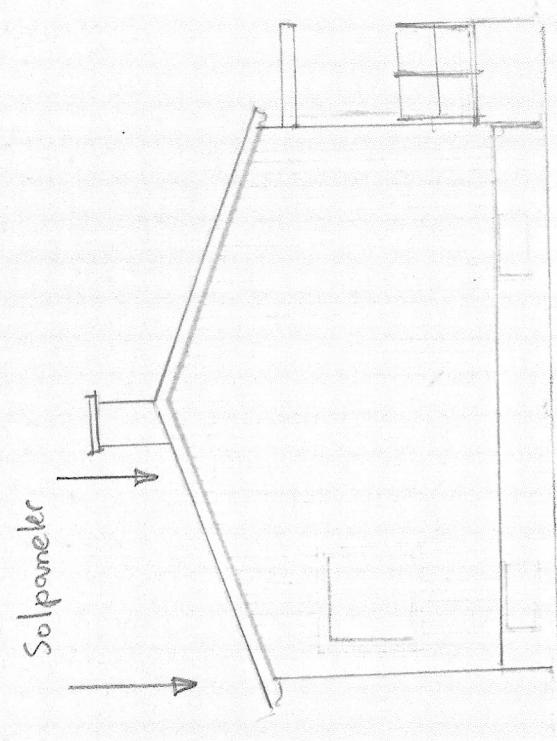
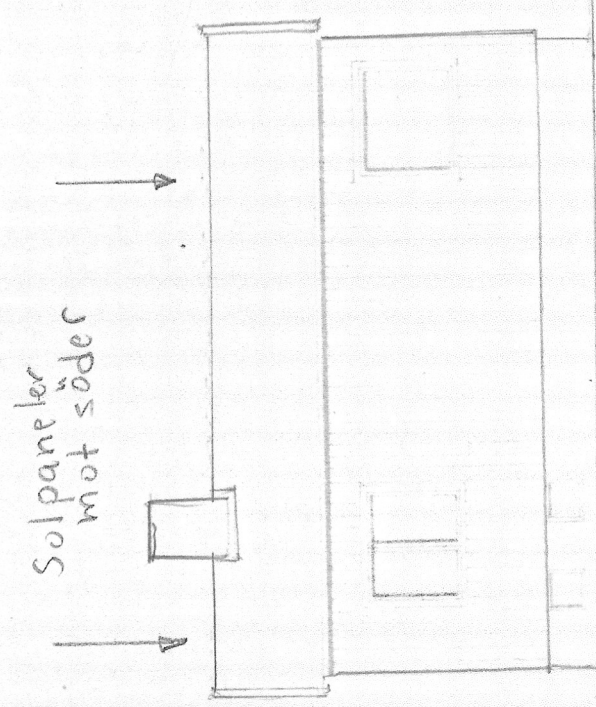


HB. TILL BYGGNADSKÄNDEL
30 AUG. 1939

1939

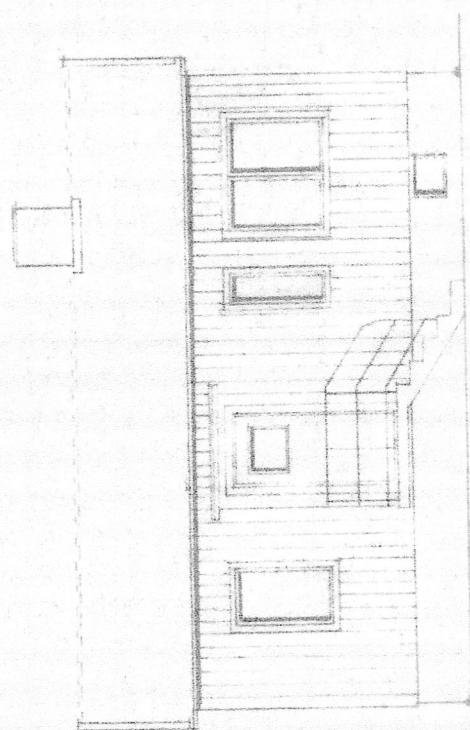

7,95 8,25