
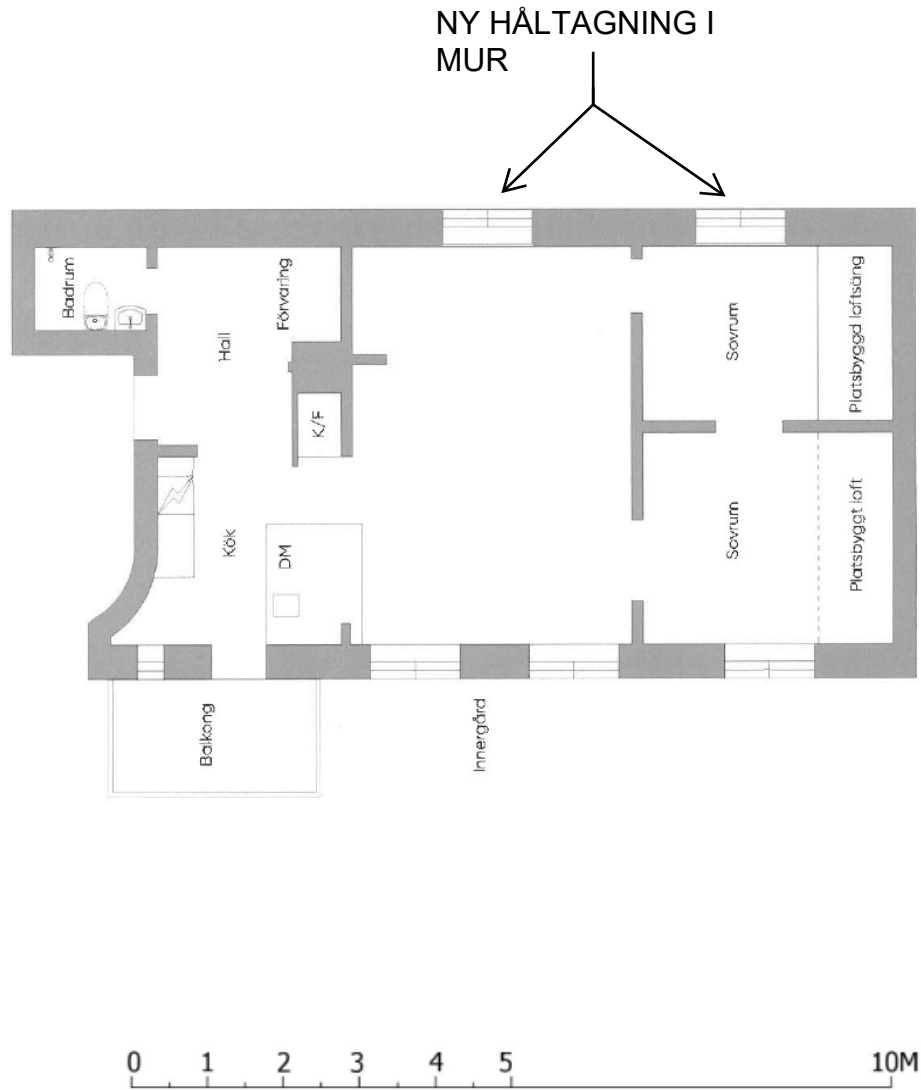


SKALA 1:100

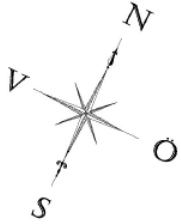

Lägenhet 1202