





Room Number	Area (m²)
1	32,5
2	25
3	33
4	25
5	38
6	25
7	29
8	26
9	25
10	41
11	35
12	31,5
13	36
14	32
15	25
16	33
17	25
18	32,5

Other labels and dimensions include: "Bef ramp ca 11000", "6300", "2000", "6000", "2000", "Entré", "Postboxar", "UC", "RULLSTOL BARNVAGN", "Utrymning", "Takhöjd minst 1900 hit", and "HÄNVISNINGAR".

Plan 1 tr BOA se respektive lgh

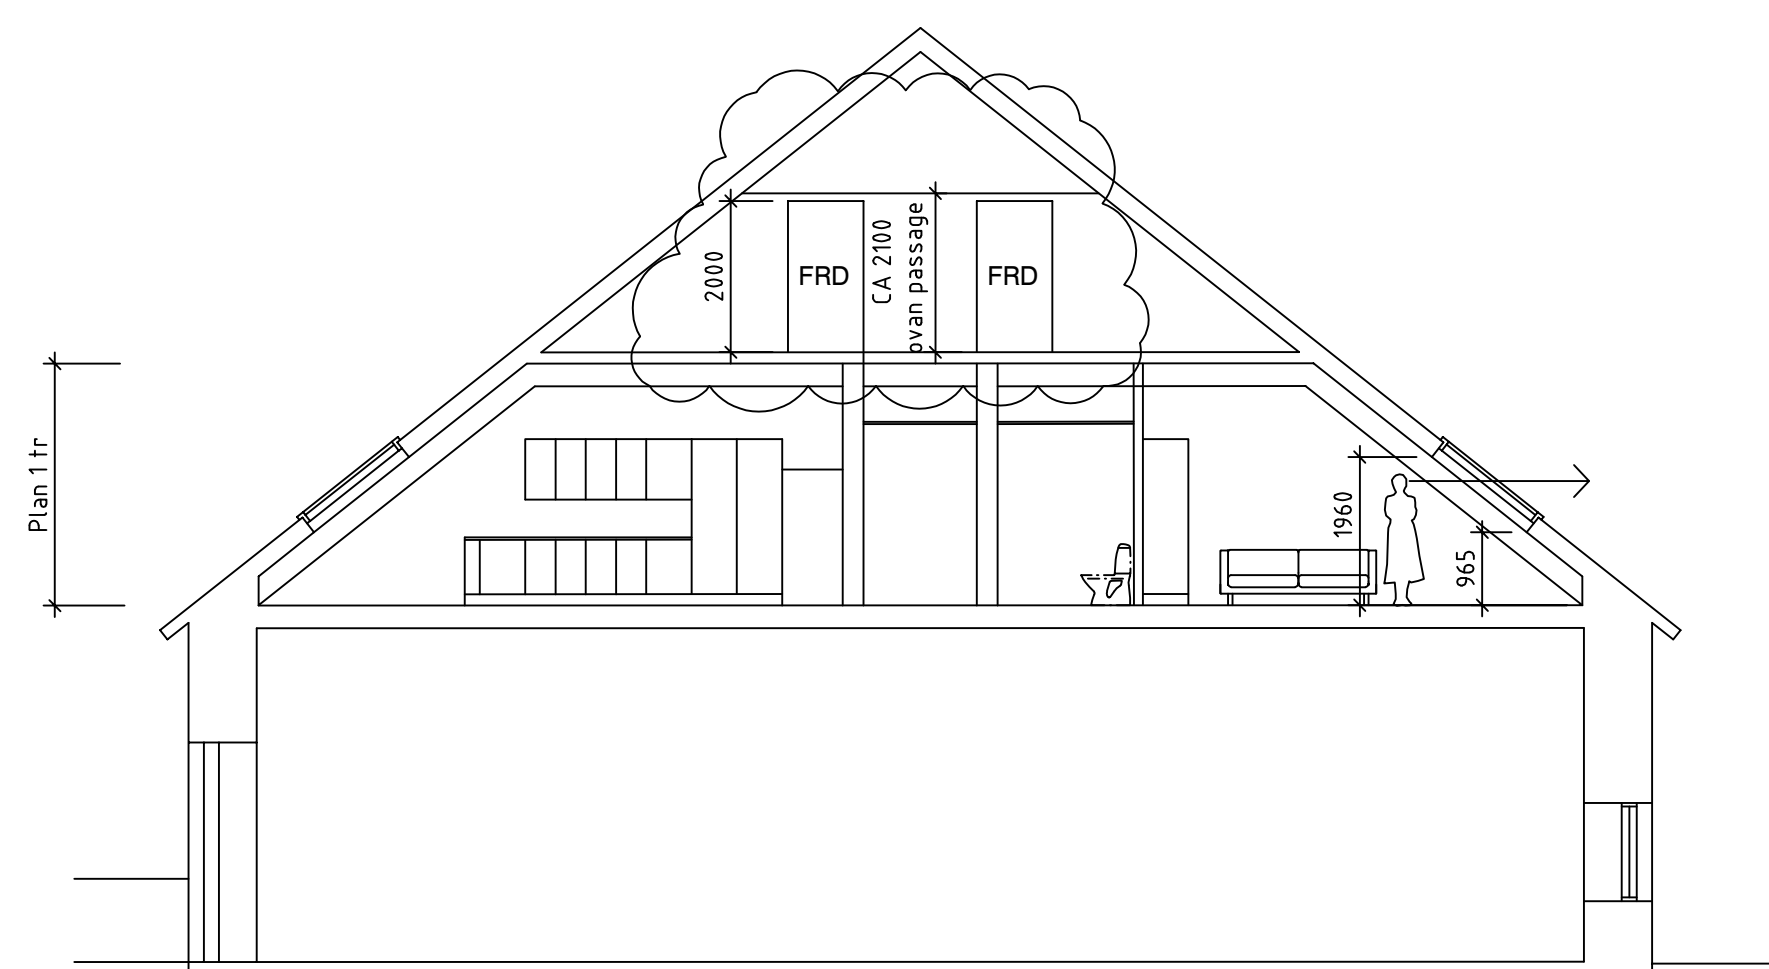

Sektion

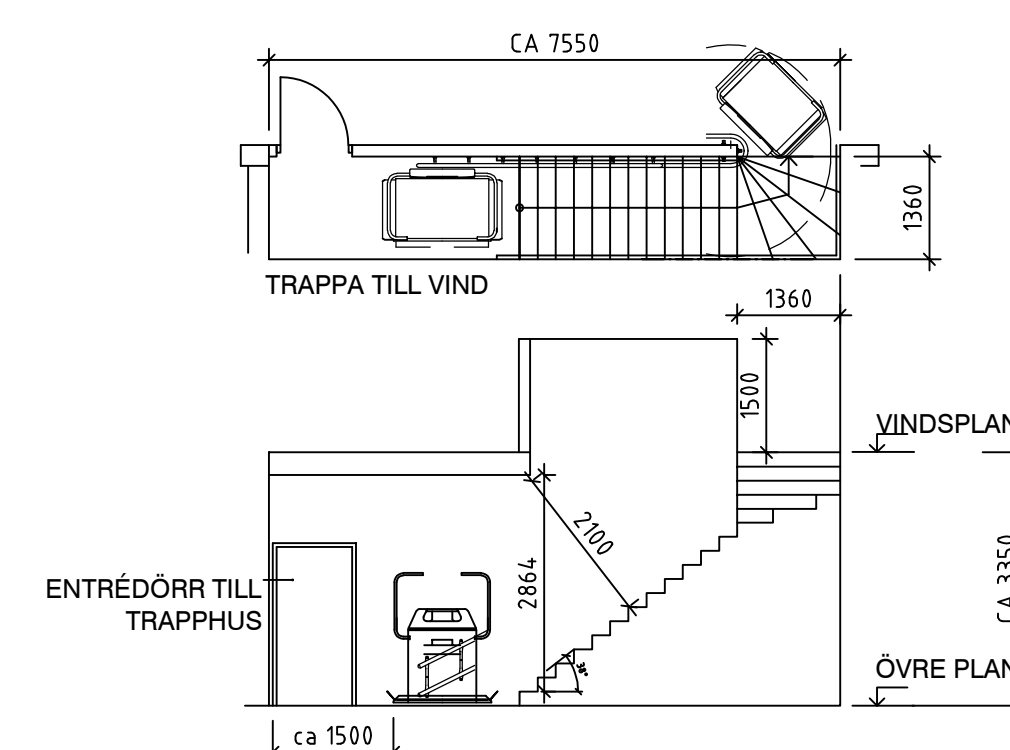

Plan/sektion trapphus till vind

B		KOMPLETTERING MÅTT VIND	VL	250312
A		JUSTERING TRAPPHUS FÖR	HISS VL	250218
BET	ANT	ÄNDRINGEN AVSER	SIGN	DATUM

LAFLAMME ARKITEKTER

BYGGLOVSHANDLING

UPPDRAK NR	RTID/KONSTR AV	HANDLÄGGARE
DATUM	VLE	VLE
2024-12-13	ANSVARIG Rickard Nyman	
PRÄSTKAMMAREN 2, HÄSSELBY		
ÖVRE PLAN		
0 METER		
HELSKALA	HALVSKALA	NUMMER
1:100	1:200	A-40.1-02
		B