


Punktnummer	X-Koordinat	Y-Koordinat	Z-Koordinat	Punktnummer	X-Koordinat	Y-Koordinat	Z-Koordinat	Punktnummer	X-Koordinat	Y-Koordinat	Z-Koordinat
6	6 573 910.279	153 123.791		1	6 573 910.275	153 137.858		1		0.009	0.005
1	6 573 910.266	153 137.853		2	6 573 901.645	153 137.858		2		0.014	-0.014
2	6 573 901.631	153 137.873		3	6 573 901.645	153 129.418		3		-0.016	0.005
5	6 573 901.542	153 123.785		4	6 573 901.545	153 129.418		4		-0.006	0.008
4	6 573 901.551	153 129.410		5	6 573 901.545	153 123.798		5		0.003	0.014
3	6 573 901.661	153 129.413		6	6 573 910.275	153 123.798		6		-0.004	0.008

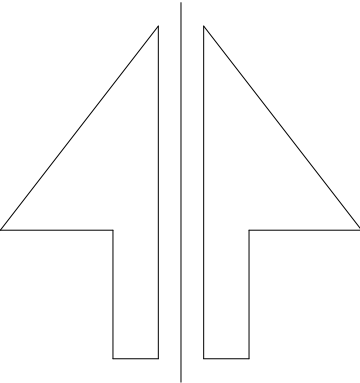

RITAD AV, KONSTRUERAD AV  
Shams Momand

ARB.NR.

170505

LÄGESKONTROLL  
STUREBY STADSVILLOR PLAN 1  
KOORDINATSYSTEM SWEREF 99 1800  
HÖJDSYSTEM:RH200  
RÖDA LINJEN:TEORETISK:BLÅ INMÄTTNING

SKALA  
1:50

HÖJDSKALA

RITNINGSNUMMER

REV