


Fördelarskåp: 2-2  
Systemtemp.: 42,0 /35,0 °C  
Flöde: 508 l/h / 8,5 l/min  
Max tryckfall: 19,6 kPa


Krets	System variant	c/c	Längd (m)	Inj.värde VKF RF
2:1	G16	240	31	0,25
2:1a	G16	240	14	0,25
2:1b	G16	240	20	0,25
2:2	G16	320	81	4,50
2:3	G16	240	68	0,75
2:4	G16	240	44	0,25
2:5	G16	240	62	0,25
2:6	G16	240	50	0,25
2:7	G16	240	27	0,25

Fördelarskåp: 2-3  
Systemtemp.: 42,0 /35,0 °C  
Flöde: 147 l/h / 2,5 l/min  
Max tryckfall: 11,9 kPa

Krets	System variant	c/c	Längd (m)	Inj.värde VKF RF
1:1	G16	240	59	4,50
1:2	G16	240	69	0,25

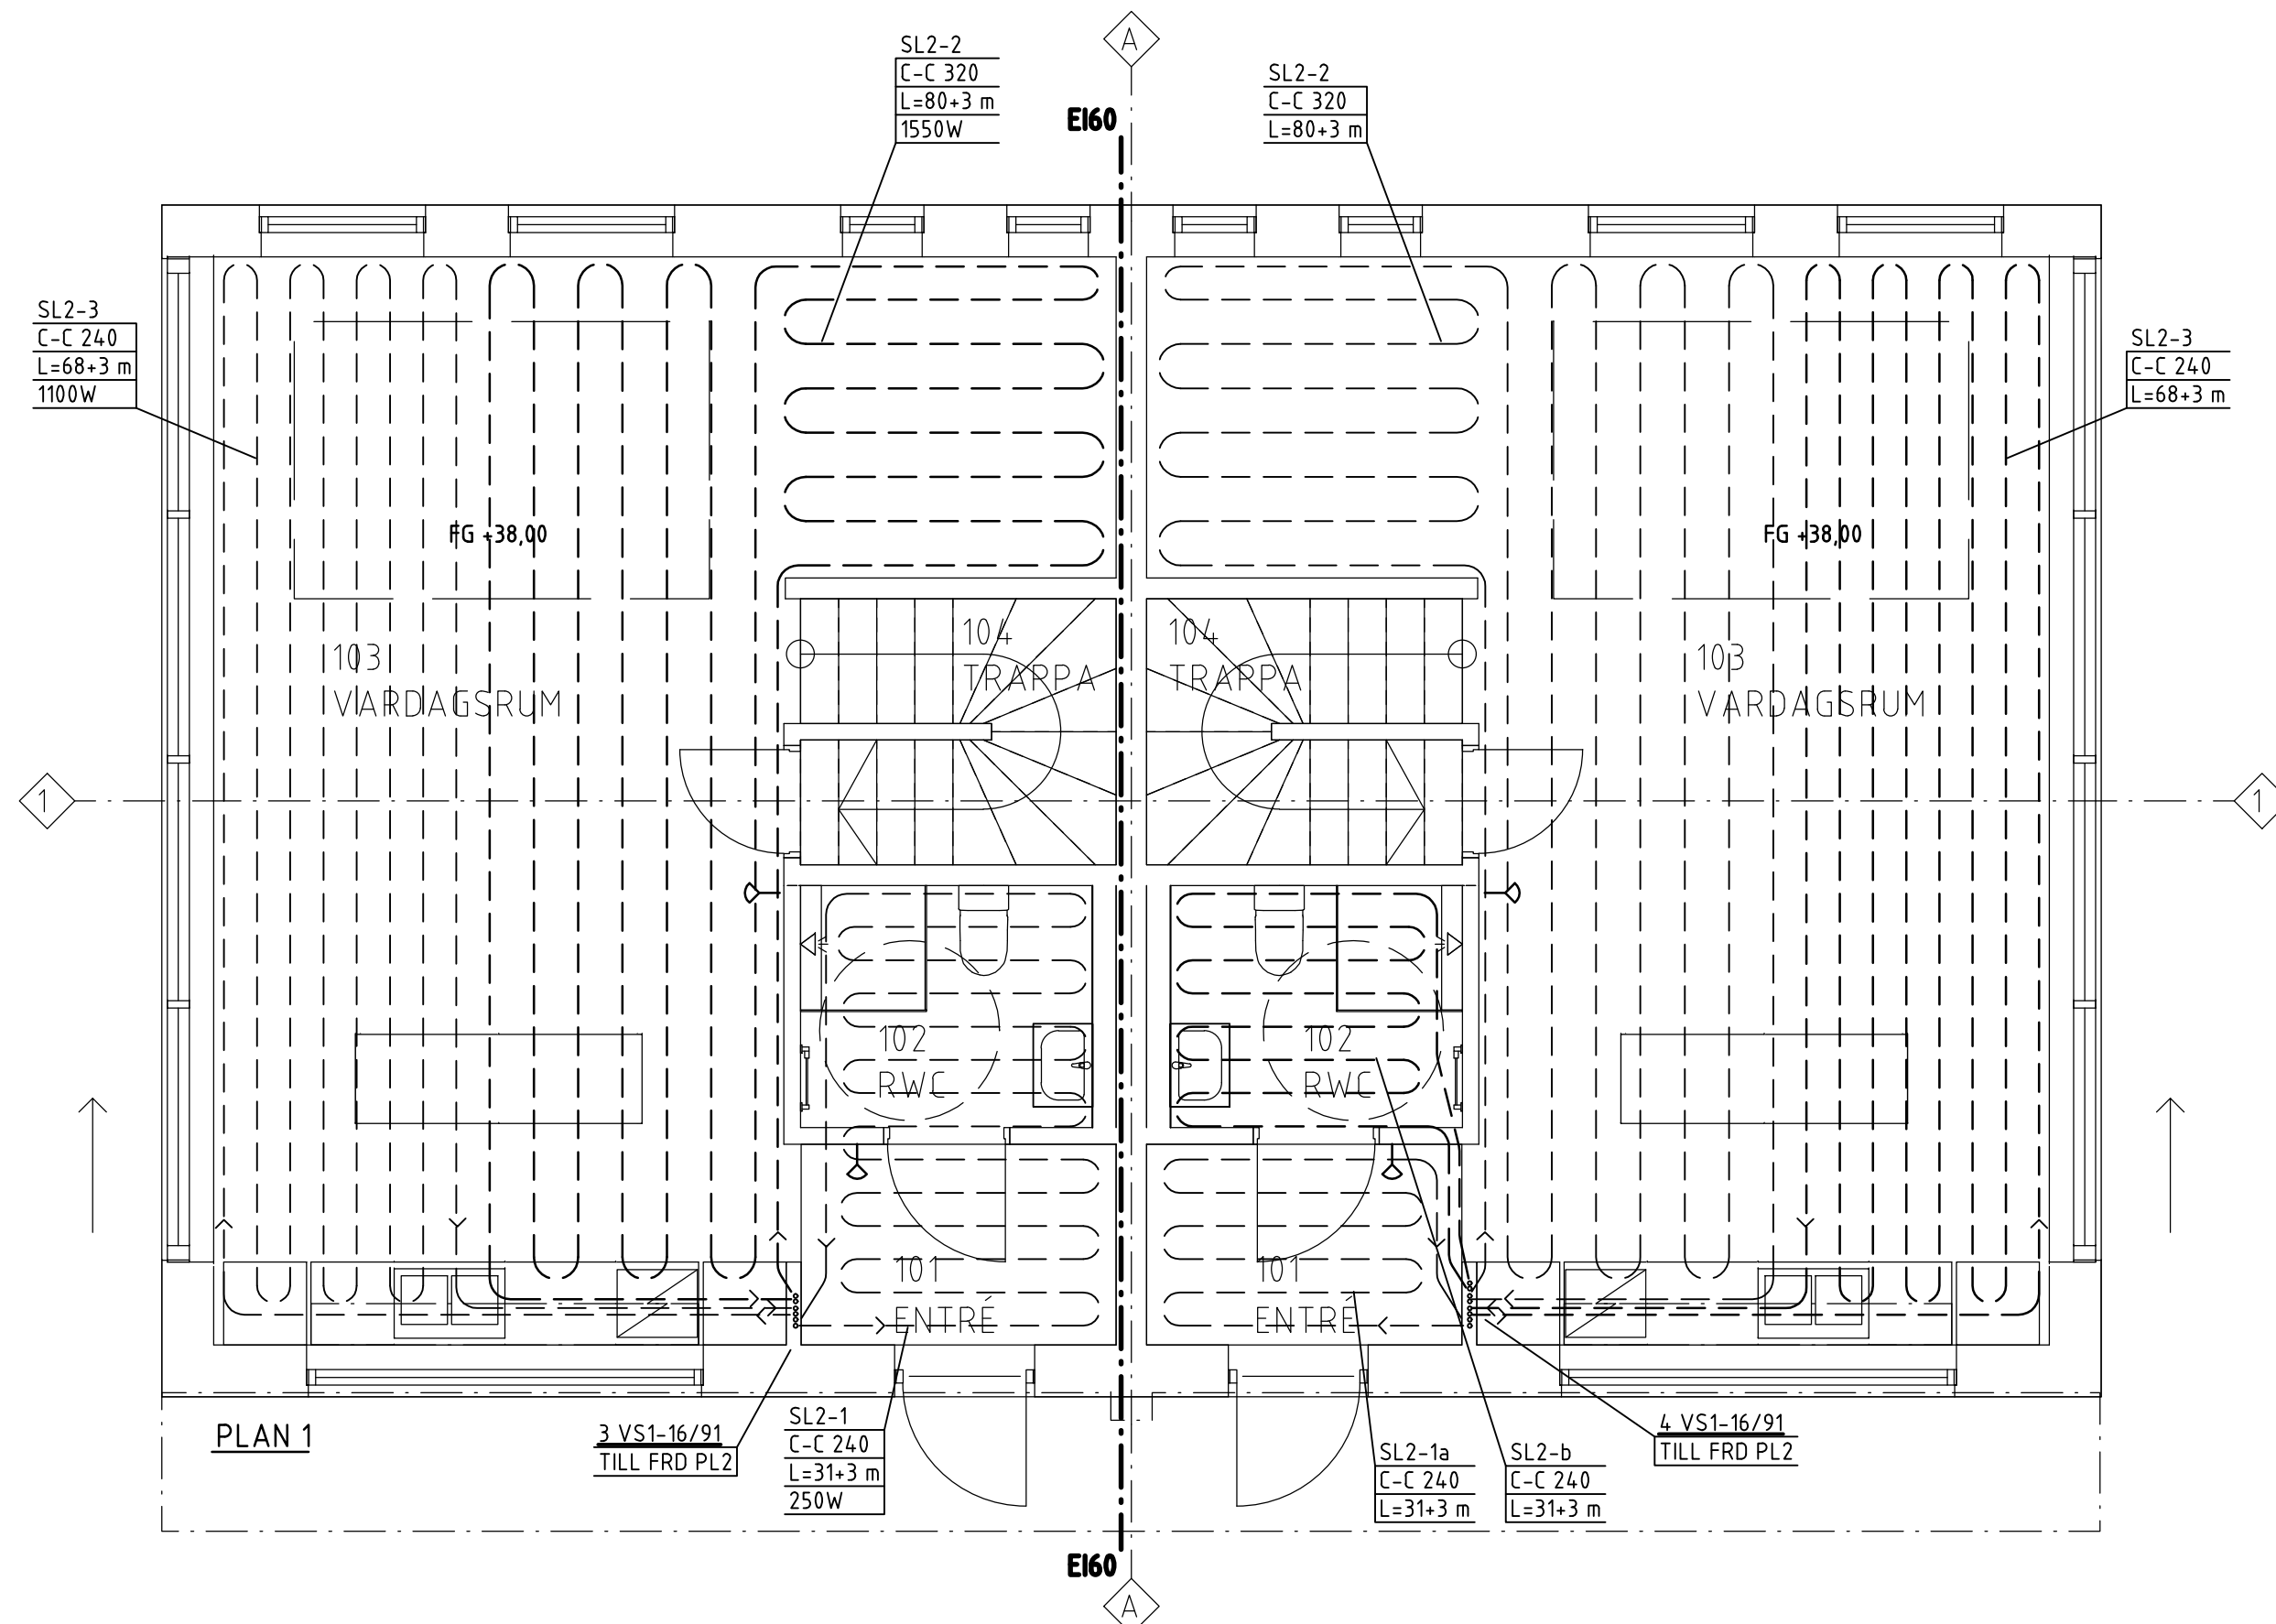

SKALSTOCK 1:50

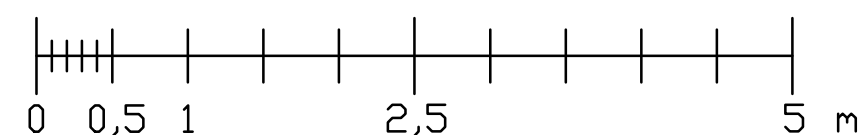

A	-	RELATIONSRTNING	LBT	2017-12-18
BET	ANT	ÄNDRINGEN AVSER	SIGN	DATUM
RELATIONSRTNING				
STUREBY STADSVILLOR				
TUSSMÖTETORPET 19				
TUSSMÖTEVÄGEN 236, 122 64 ENSKEDE				
 <b>NINE DOORS</b> PROPERTIES				
A	LILJEWALL ARKITEKTER AB		010-205 10 80	
K	Knut Jönsson Ingenjörbyrå AB			
<input checked="" type="checkbox"/> V	Pelator VVS projektering AB			
E	Elodesign Ingenjörbyrå AB			
</				