


TORKHUSET 1

TORKHUSET 4

FASAD MOT NORR, GÅRD

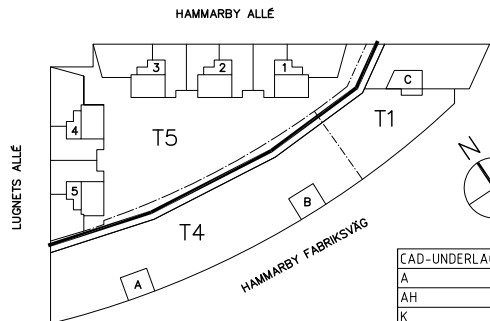

EV	ANT	REVIDERINGEN AVSER	SIGN	DATUM																																
SKANSKA																																				
RELATIONSHANDLING																																				
TORKHUSET 1, 4 OCH 5 STOCKHOLM																																				
FAMILJEBOSTÄDER AREIM																																				
<table><tr><td><input checked="" type="checkbox"/></td><td>A</td><td>ERSÉUS ARKITEKTER AB</td><td>08-556 939 00</td></tr><tr><td><input type="checkbox"/></td><td>AH</td><td>ON ARKITEKTER AB</td><td>08-599 090 89</td></tr><tr><td><input type="checkbox"/></td><td>K</td><td>ELU KONSULT AB</td><td>08-622 91 08</td></tr><tr><td><input type="checkbox"/></td><td>E</td><td>ELPLANERING AB</td><td>08-410 986 72</td></tr><tr><td><input type="checkbox"/></td><td>V</td><td>RAGNAR SANDSTRÖM AB</td><td>08-644 02 95</td></tr><tr><td><input type="checkbox"/></td><td>W</td><td>RAGNAR SANDSTRÖM AB</td><td>08-644 02 95</td></tr><tr><td><input type="checkbox"/></td><td>M</td><td>L CRAMMER PROJEKTBYRÅ AB</td><td>08-85 03 50</td></tr><tr><td><input type="checkbox"/></td><td>-</td><td>-</td><td>-</td></tr>
UPPRAG NR 1190		RITAD AV ME, LJ		HANDÄGARE JL, ME																																
DATUM 2010-03-01		ANSVAREG J LARSSON																																		
FASAD MOT GÅRD, NORR																																				
CAD-UNDERLAG A		DATUM 2010-03-01																																		
AH																																				
K																																				
V																																				
W																																				
E																																				
SKALA A1+ 1:200 A3+ 1:400		NUMMER A-40.3-T006		I REV																																