

FÖRKLARINGAR

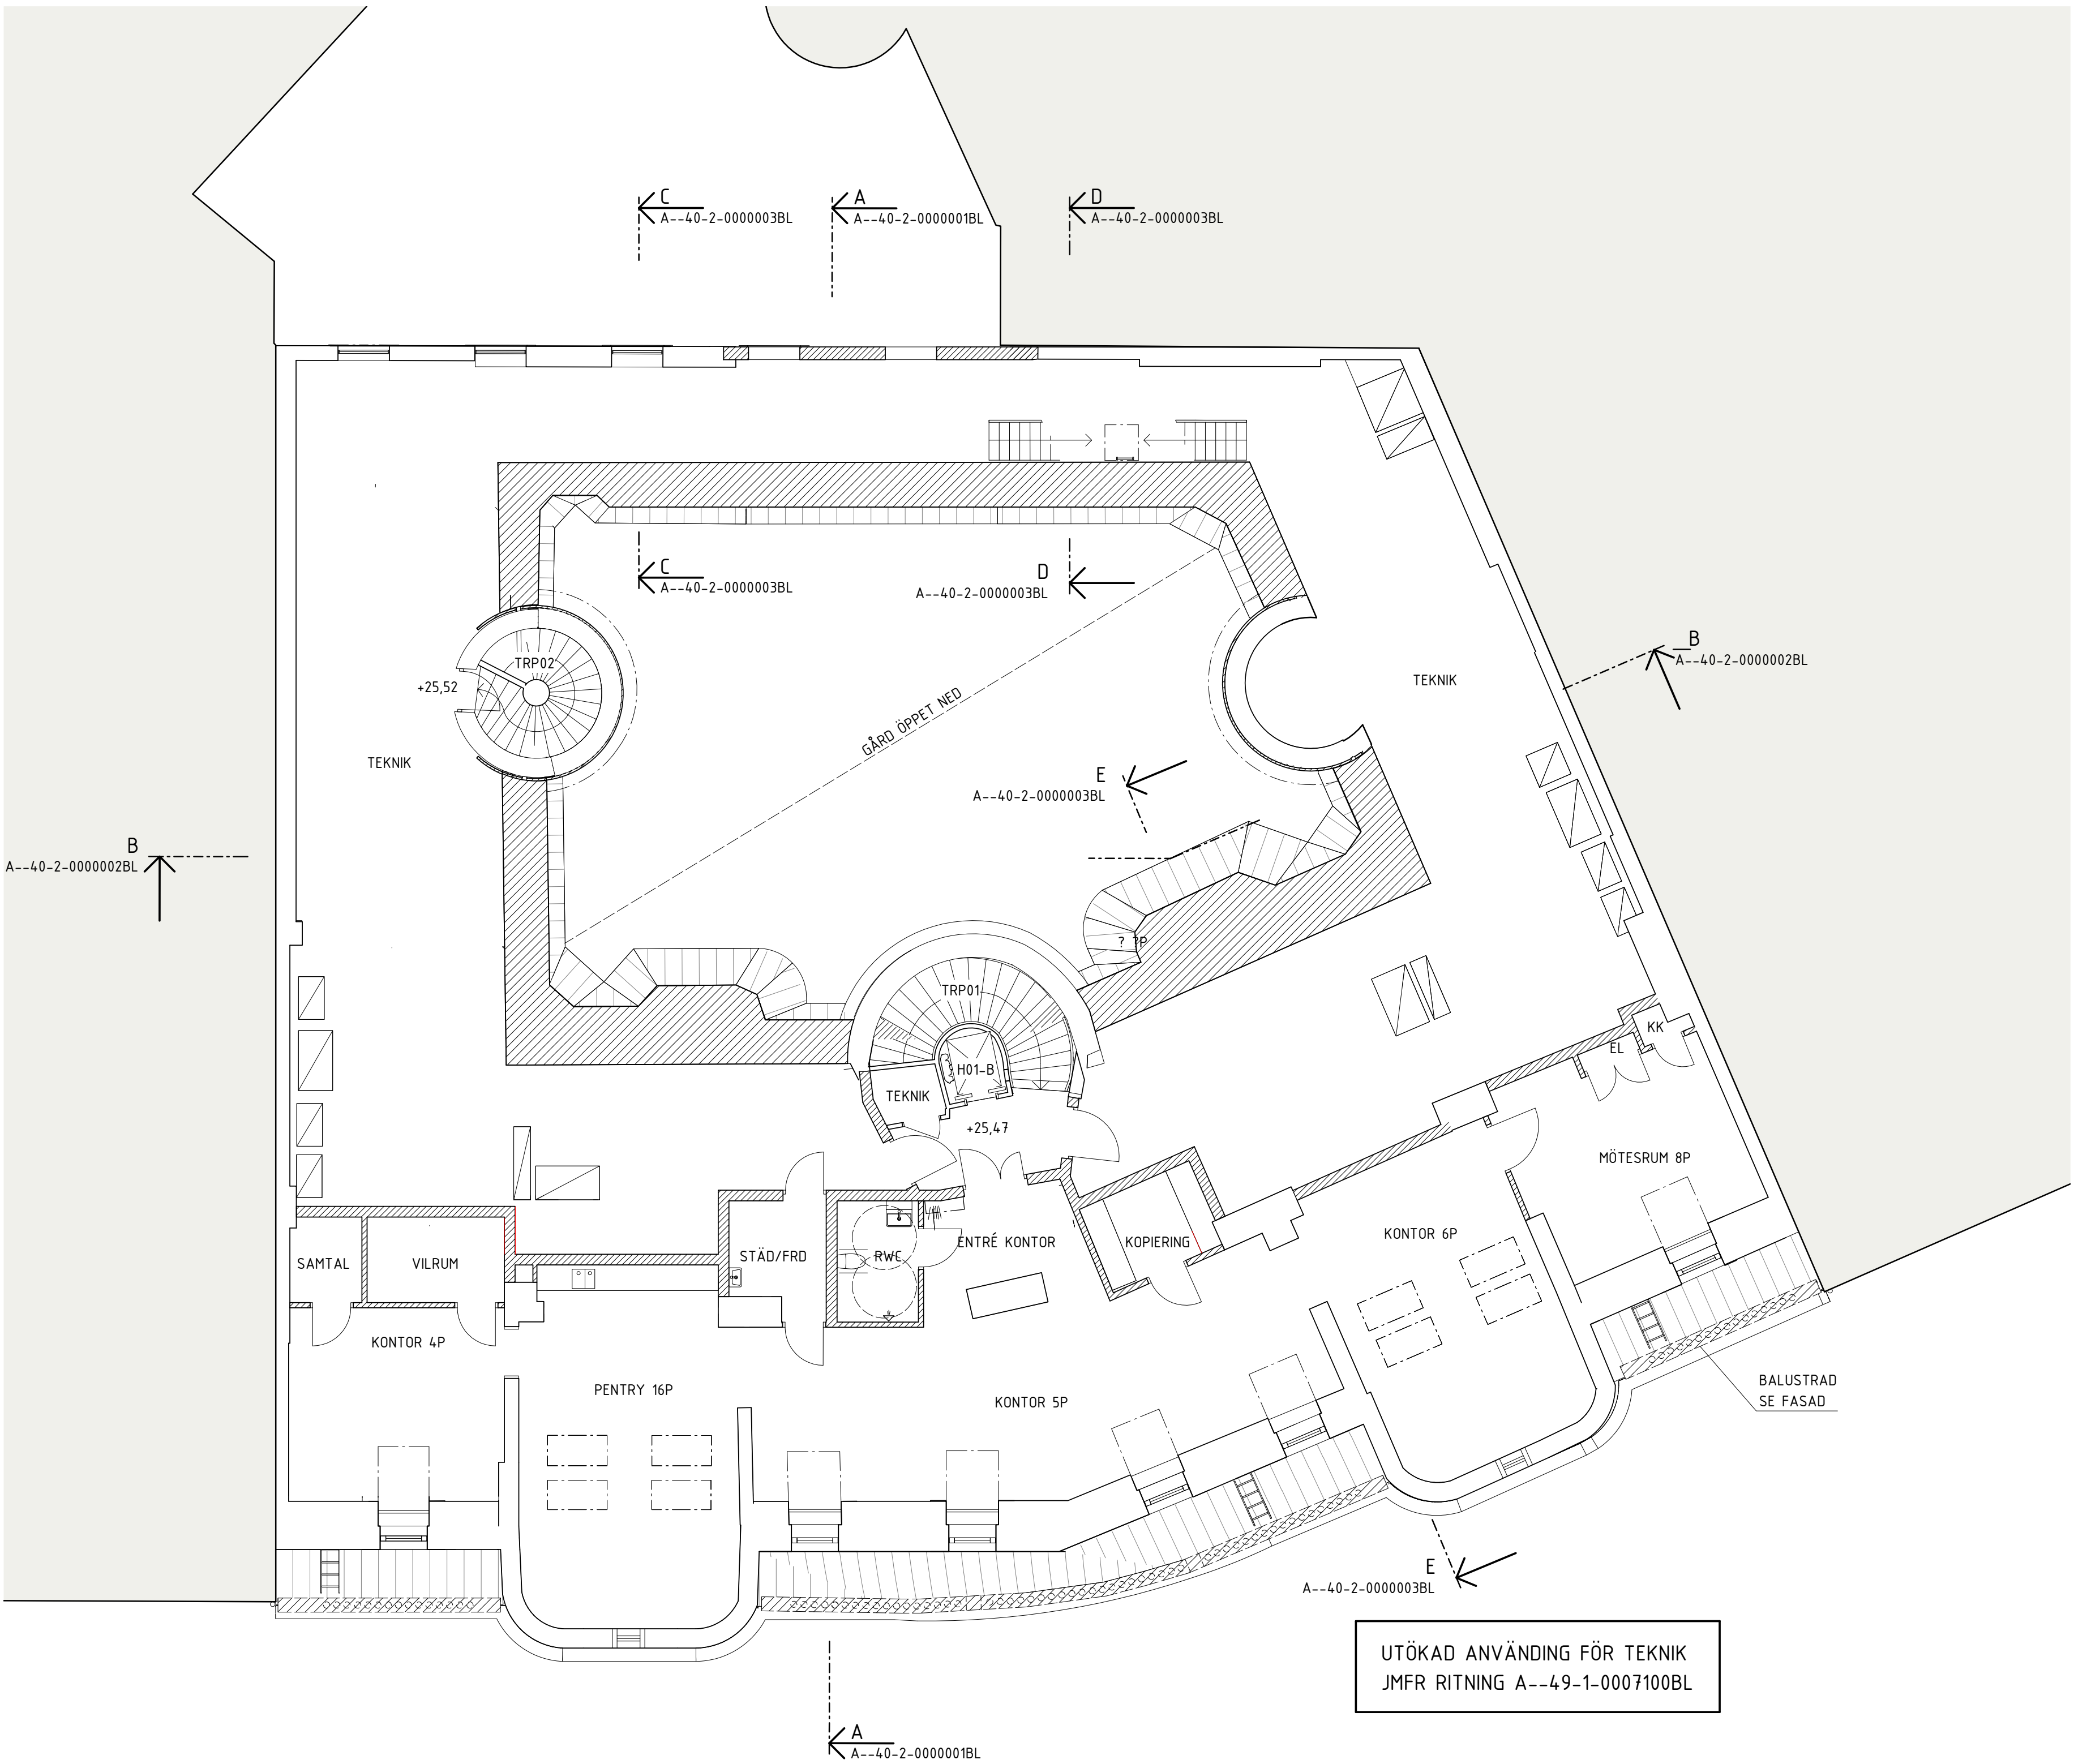
SE A--40-1-0001100BL

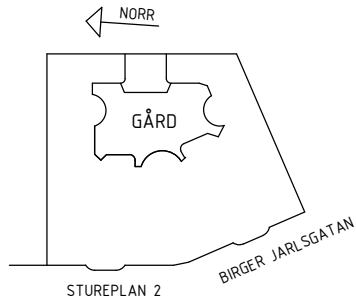
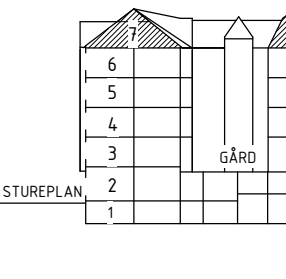
FÖRESKRIFTER

SE A--40-1-0001100BL

HÄNVISNINGAR

SE A--40-1-0001100BL



A		A BL PM 01		2020-01-31		TRS
BET		ÄNDRING AVSER		DATUM		SIGN
BYGGLOVHANDLING						
VASAKRONAN						
ORIENTERINGSFIGUR						
						
VASAKRONANS PROJEKTNUMMER		SPERLINGENS BACKE 45				
1411900007		KONTORSFASTIGHET				
(A)		WINGÅRDH ARKITEKTKONTOR AB			T: 010-788 10 00	
BR		BRIAB			T: 08-410 102 50	
E		TYRÉNS AB			T: 010-452 20 00	
K		LOOSTRÖM			T: 08-755 11 60	
SP		CONVISE STOCKHOLM AB			T: 08-400 297 50	
S		ÄF-INFRASTRUCTURE AB			T: 010-505 00 00	
V		ÄF-INFRASTRUCTURE AB			T: 010-505 00 00	
W		ÄF-INFRASTRUCTURE AB			T: 010-505 00 00	
-		-			T:	
C		SWECO			T: 08-695 60 00	
INGÅENDE DELENTREPRENADER						
UPPDRAG NR		RITAD/KONSTR AV		HANDLÄGGARE		
062 016		N. CHABAN		T.-R. SÖDERSTRÖM		
DATUM		ANSVARIG		FASTIGHET/KST		BYGGNAD
2020-01-31		M. WAHLGREN		14119		001
KONTOR, OM- OCH TILLBYGGNAD						
PLAN 07 (VIND)						
SKALA		NUMMER			REV	
1:100		A--40-1-0007100BL			A	
ORIGINALFORMAT: A1						

