


POINT	NORTH	EAST	Z
1	6581739.497	143562.469	
2	6581807.118	143568.819	
3	6581778.943	143602.834	
4	6581780.097	143603.595	
5	6581776.794	143607.560	
6	6581768.019	143600.248	
7	6581763.262	143613.844	
8	6581766.864	143622.886	
9	6581737.360	143634.386	
10	6581711.302	143658.403	
11	6581704.579	143651.108	
12	6581730.647	143627.083	
13	6581733.800	143625.127	

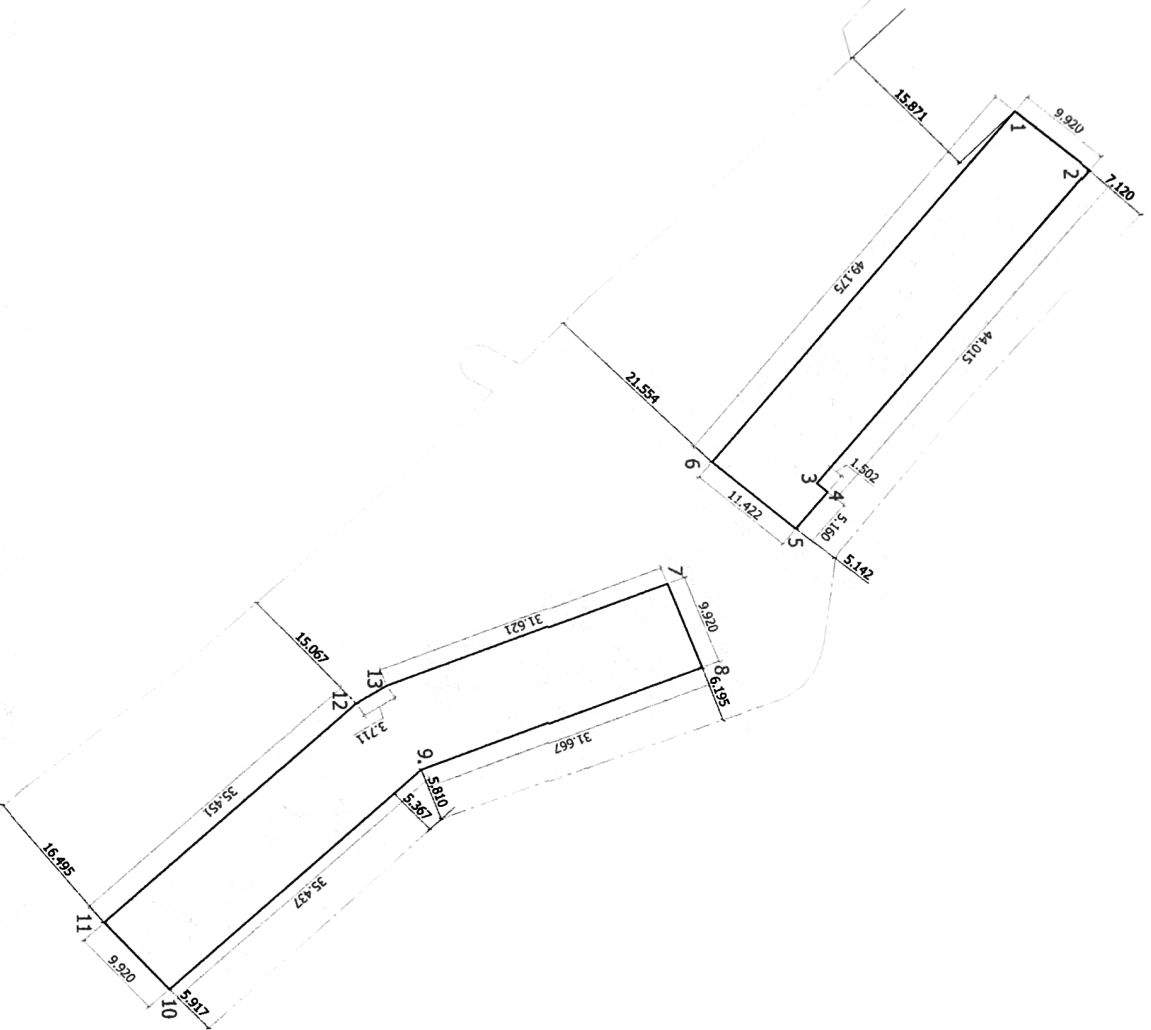

<b>NORRLAND VA</b>	
— TOTALMARKENTREPPENAD —	
PROJEKT	
Grimsta 1:5 NR 2	
Bergslagsvägen XX	
UPPDRAGS NR	RITAD AV
-	Dainis Martinsons
DATUM	
2020-01-23	
Lägeskontroll	
SKALA	KODGNINGSSTYCKE
1:500 A3	Sweref99 1800
	RH2000
	A