
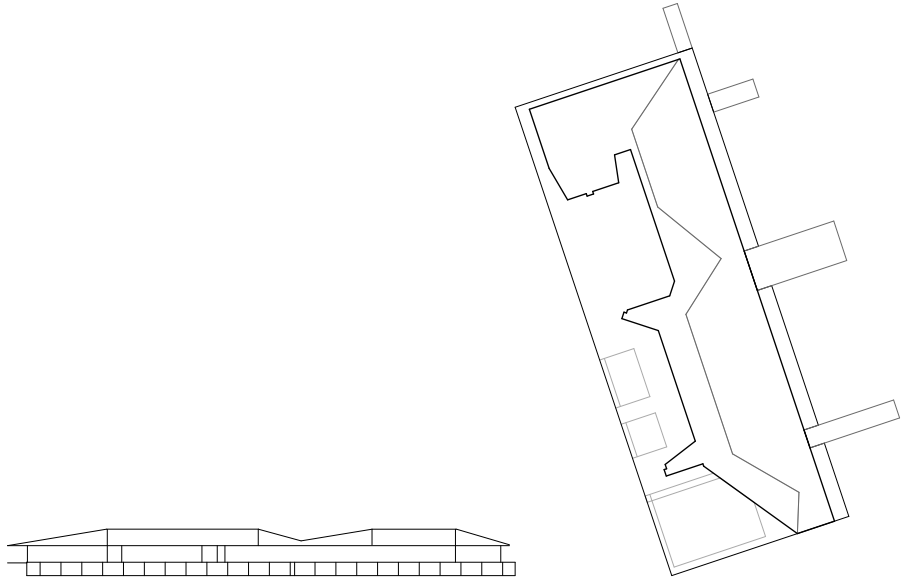
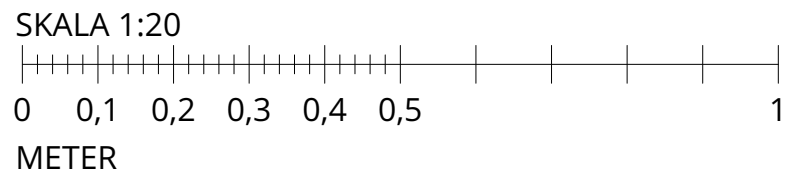
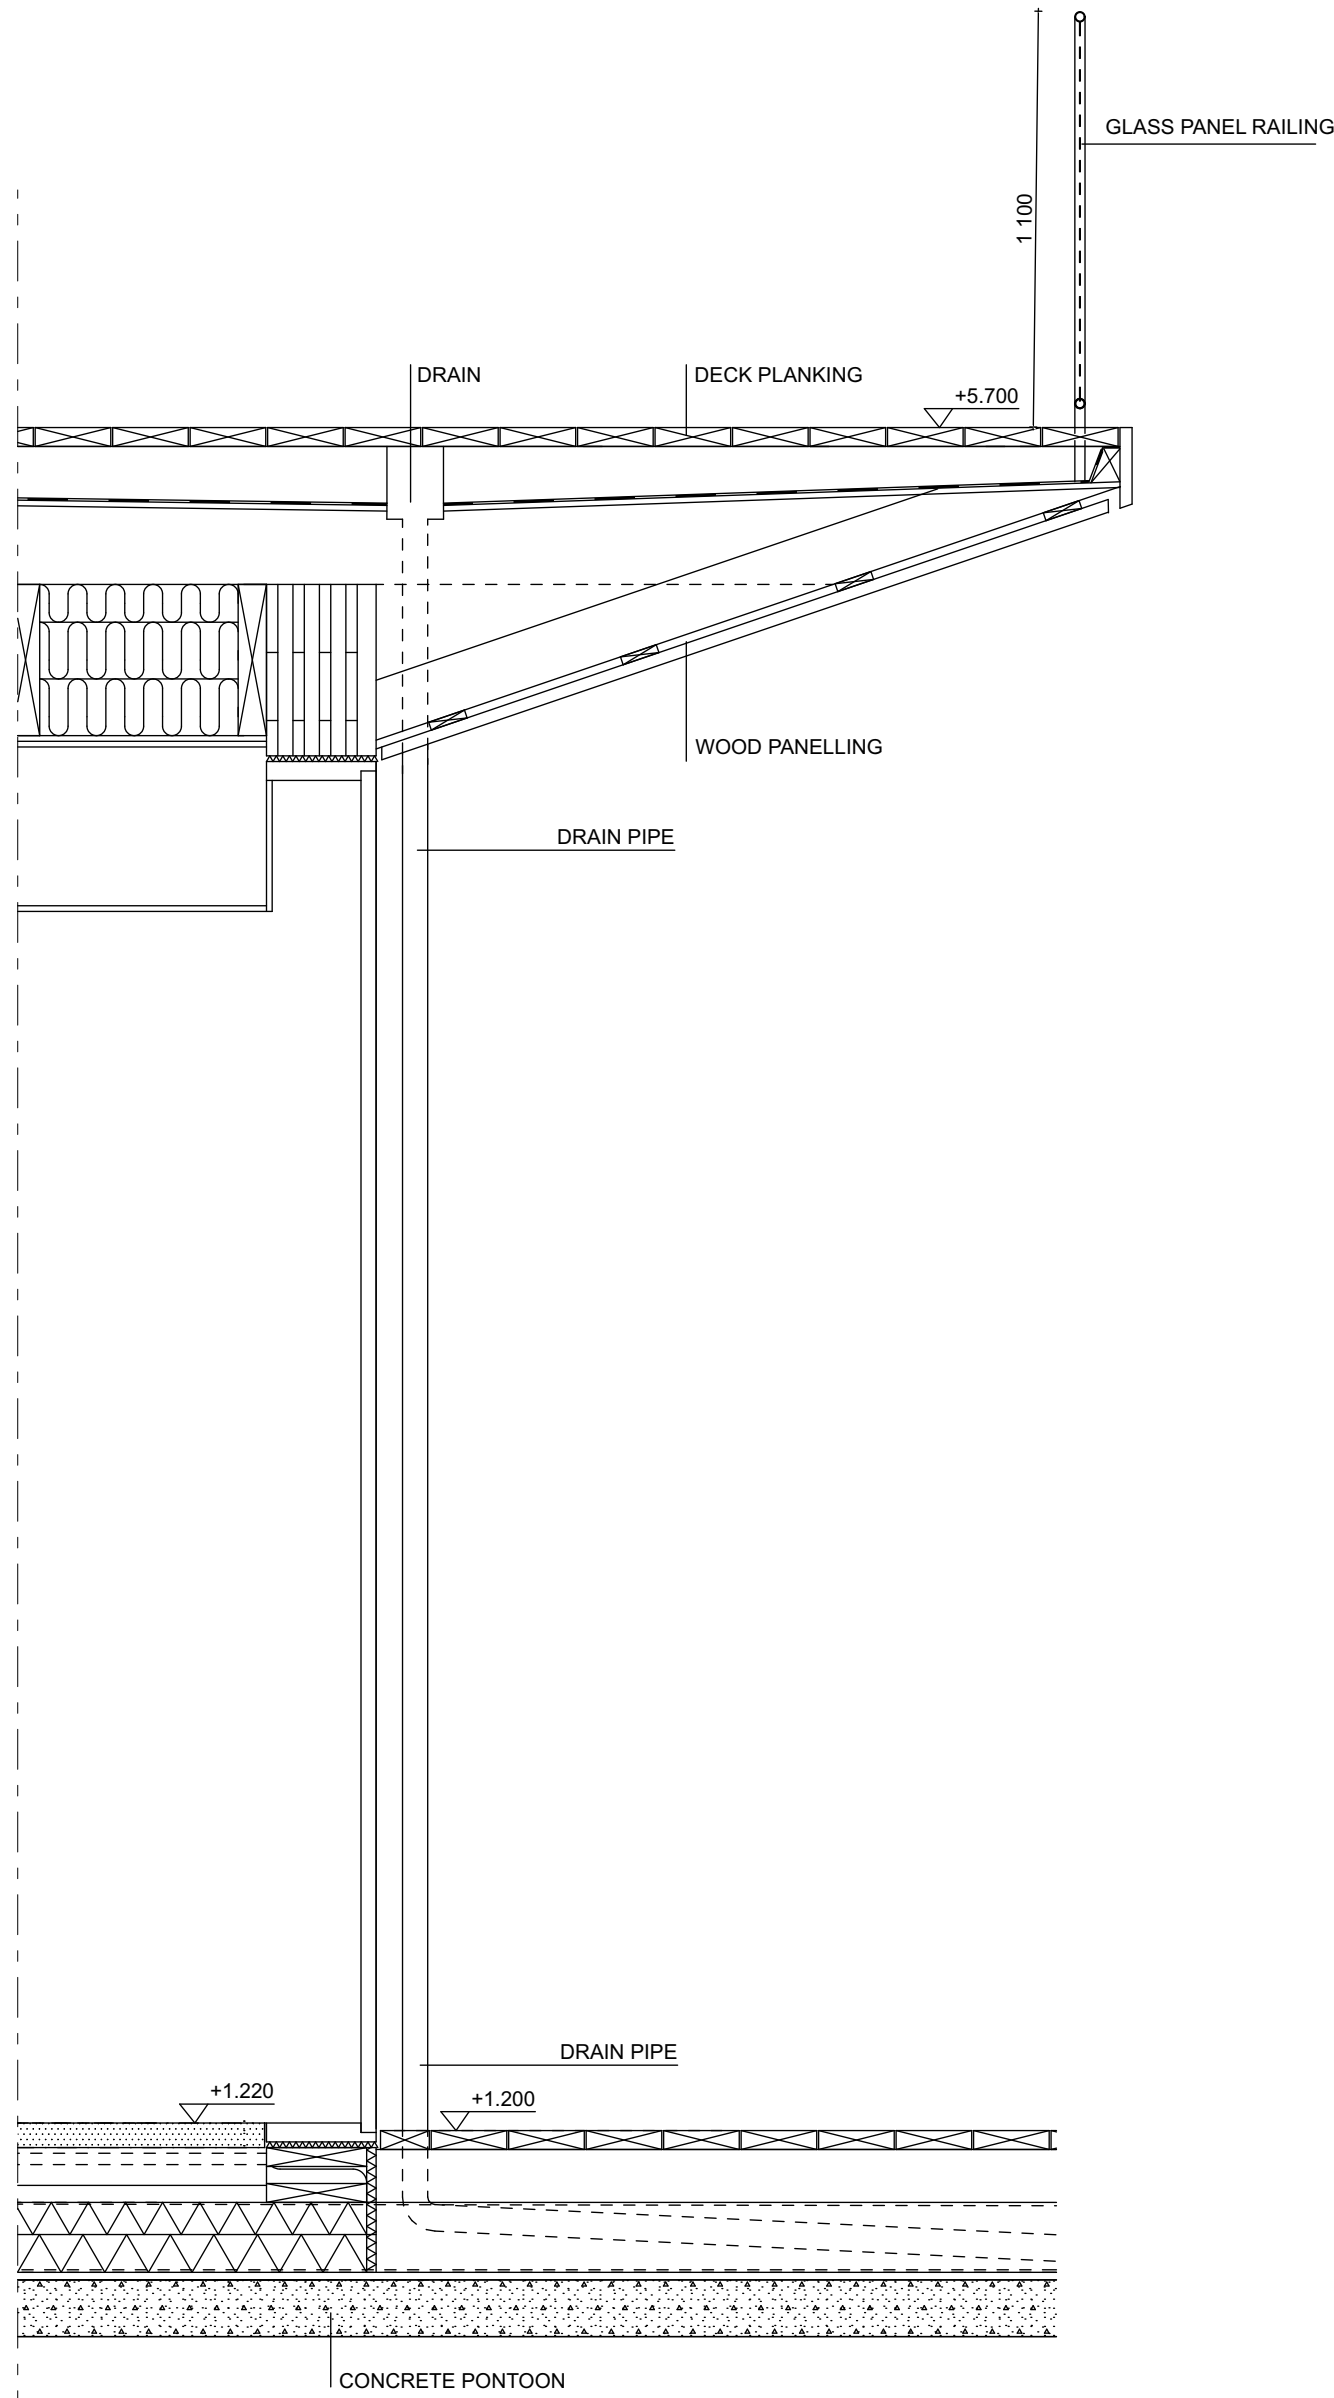
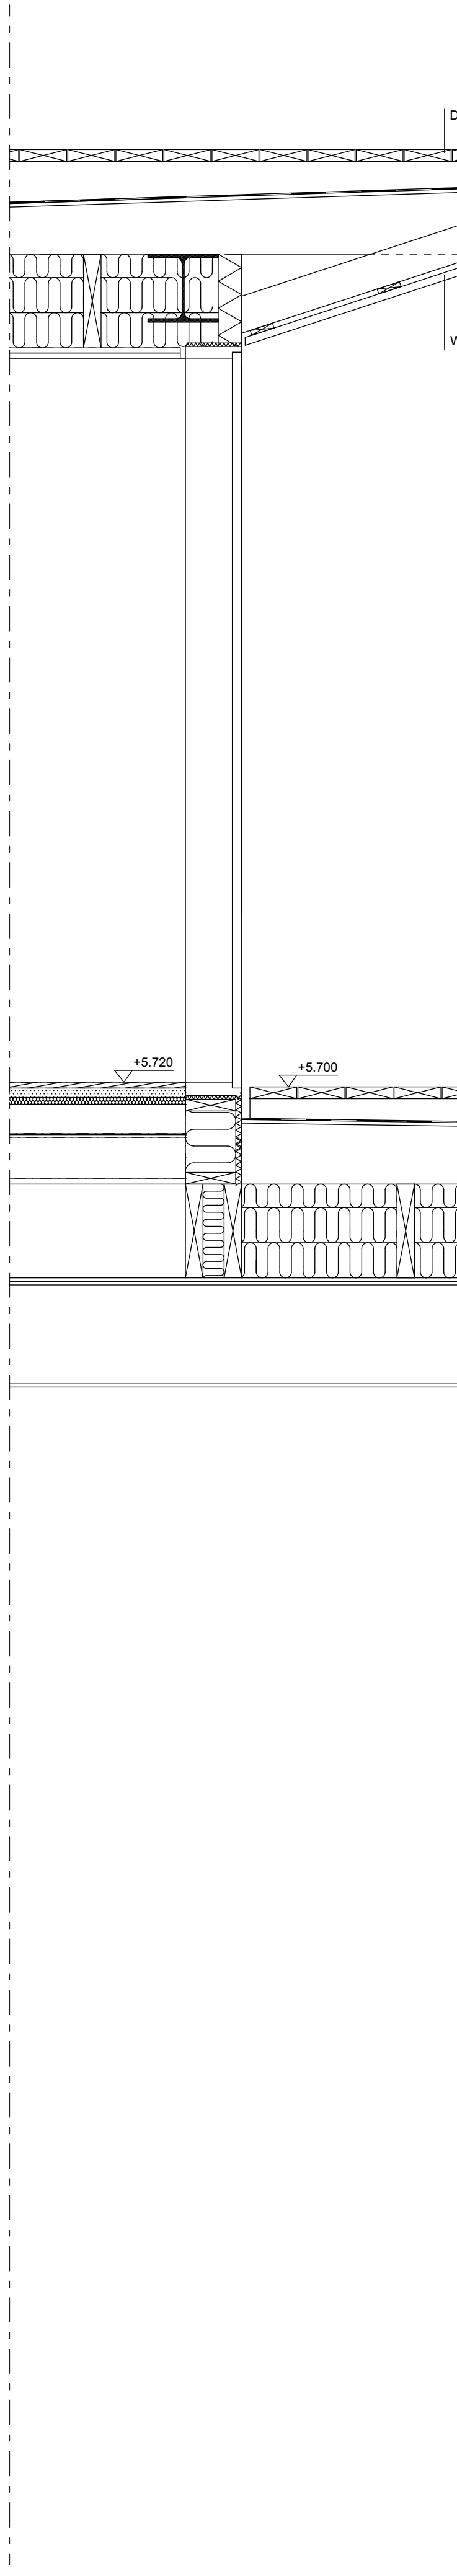


Inkom till Stockholms stadsbyggnadskontor - 2021-05-17, Dnr 2020-11119

Takfot och fasad, principdetaljer 1:10

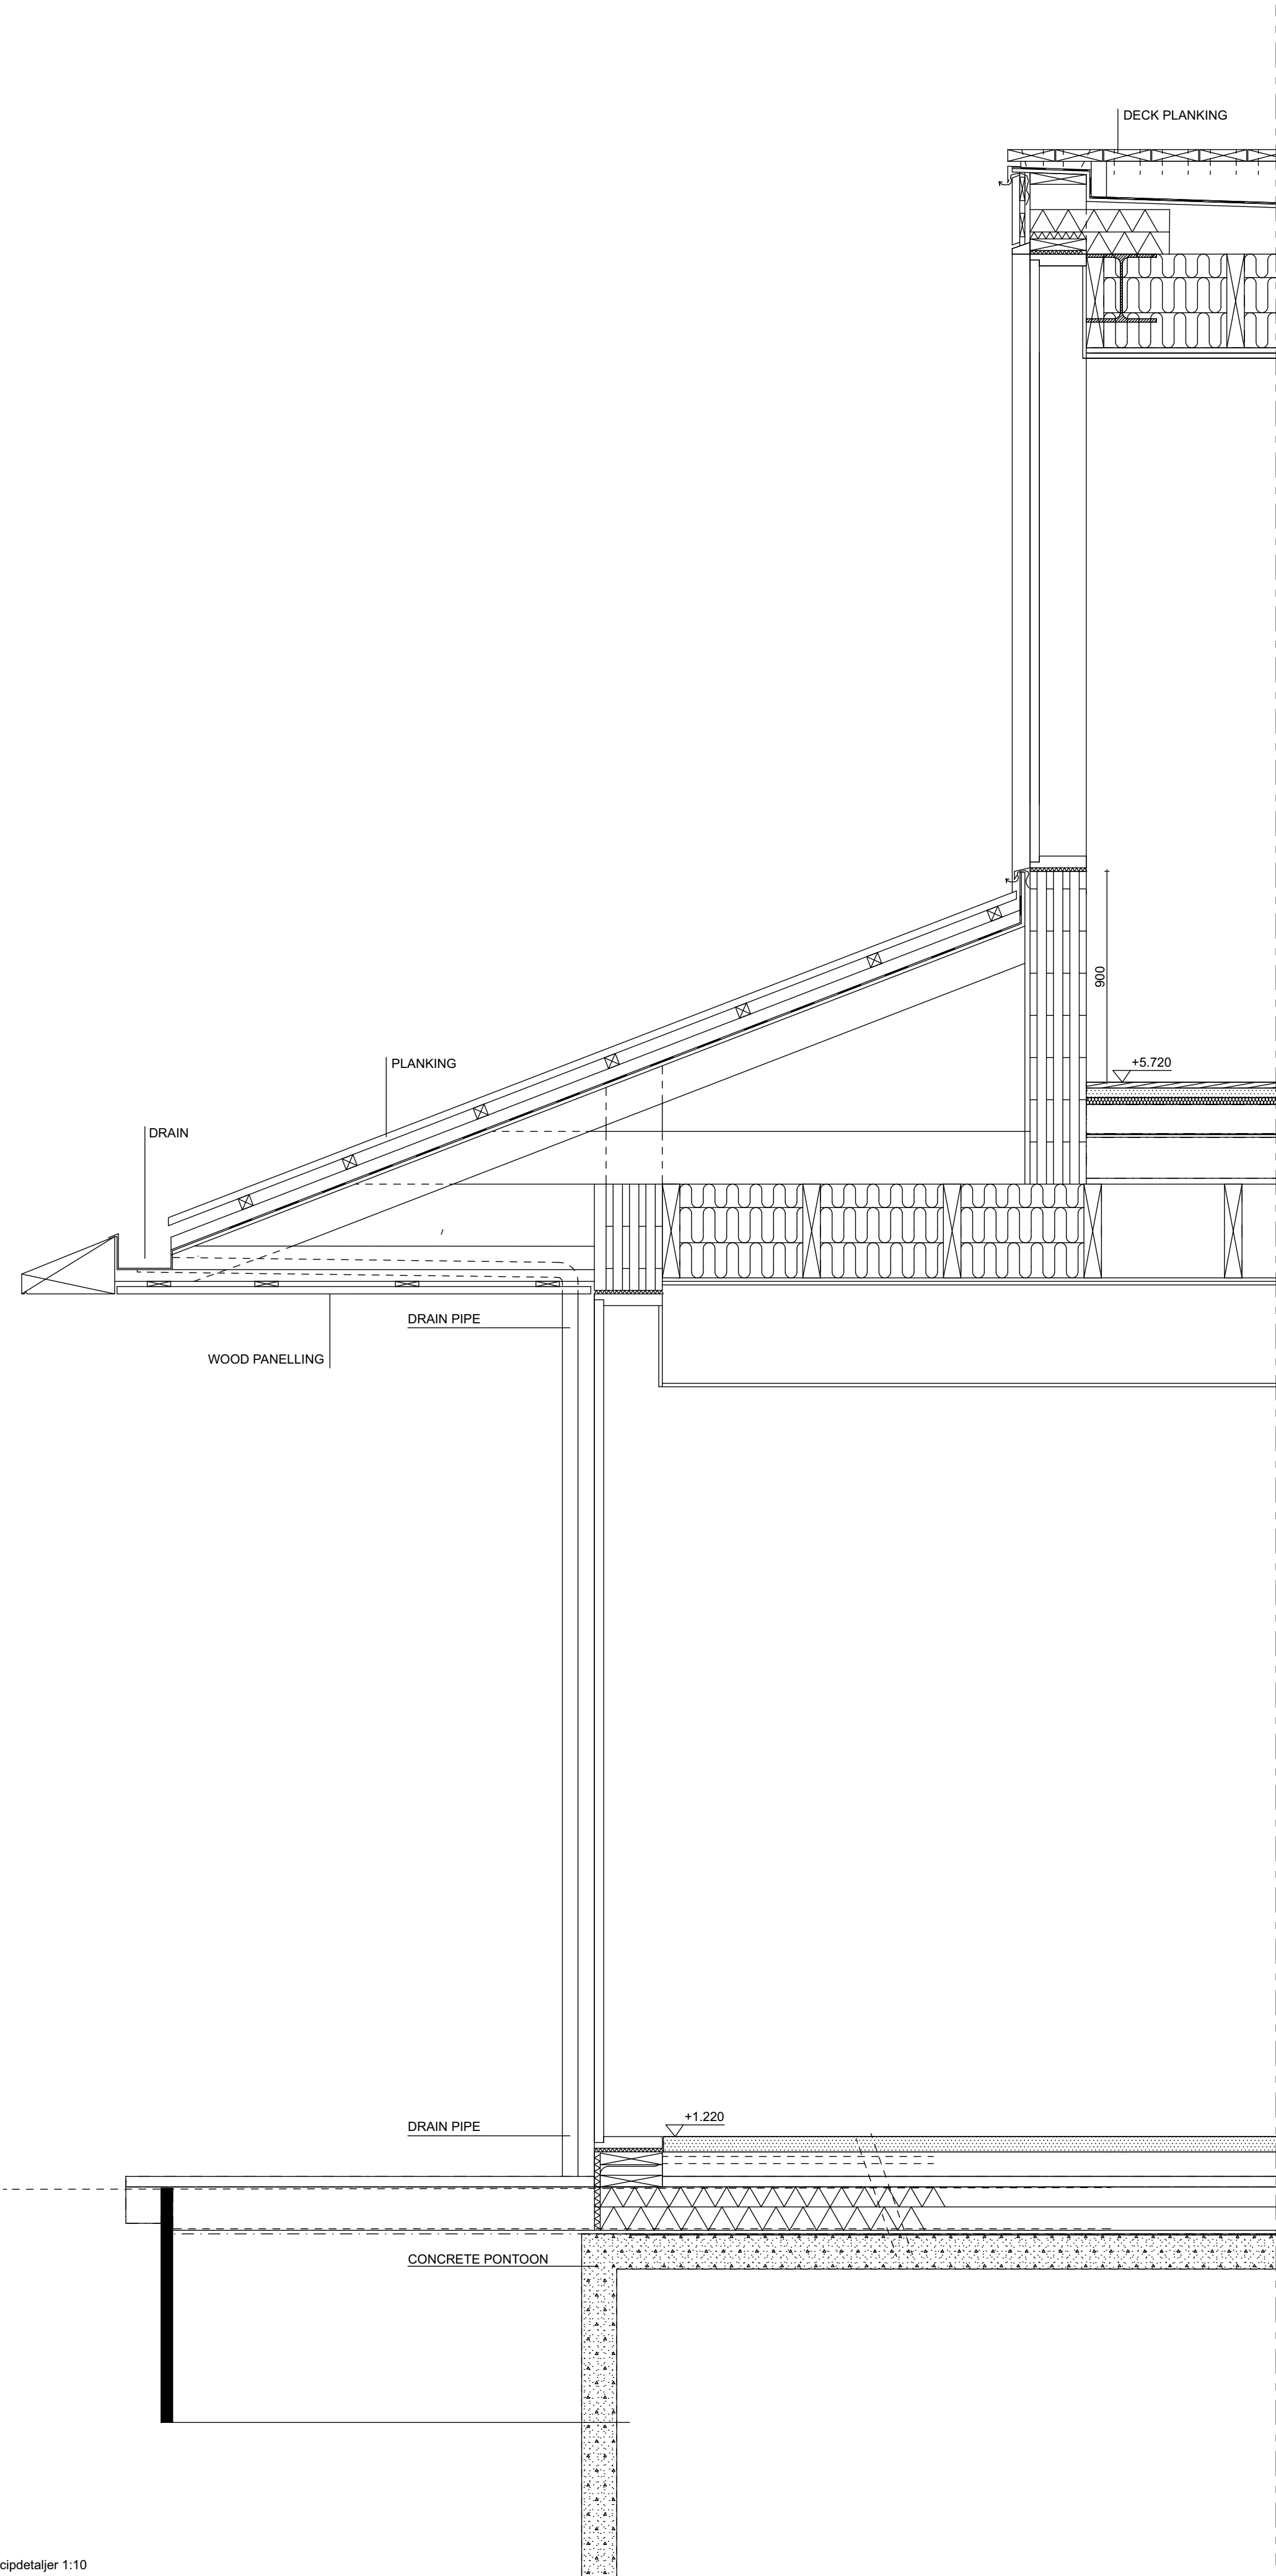

A	10.05.2021	The direction of the roof boarding of the box has been changed to vertical and the eaves detail of the box has been changed	AM
		The lower eave has been straightened	
		The eave detail above the rood window edge has been straightened vertical and the roofing blanks have been extended to meet edge	

BET	DATUM	ÄNDRINGAR AVSER	SIGN
-----	-------	-----------------	------

Höjdsystem RH2000

STADSDEL	FASTIGHET	DIARENUMMER	
Gamla Stan	Gamla Stan 1:34	2020-11119	
BYGGNADSTYP		STATUS	SEKVN
Nybyggnad		BYGGLOVHANDLING	
ÄRENDET AVSER, ADDRESS		BETECKNING	SKALA
Flytande badhus och multifunktionsbyggnad		Takfot och fasad - principdetaljer	1:20

Munkbrohamnen 1			
ANSVARIG ARKITEKT			
Anssi Lassila			
KONTRAKTPERSON		FIL	REV
Aki Markkanen		Takfot och fasad - principdetaljer.pdf	A
RITAD AV	DATUM	ÖMRÅDE	PROJ. NR
JP, TL	04.05.2021	ARK	1281
			NUMMER
			A-42-6-001

OOPÉAA OFFICE FOR PERIPHERAL ARCHITECTURE

SEINÄJOKI Keskustie 19 A, FI-00100 Seinäjoki +358 (0)6 414 1235
HELSINKI Etnäskatu 8, FI-00100 Helsinki +358 (0)6 364 8005